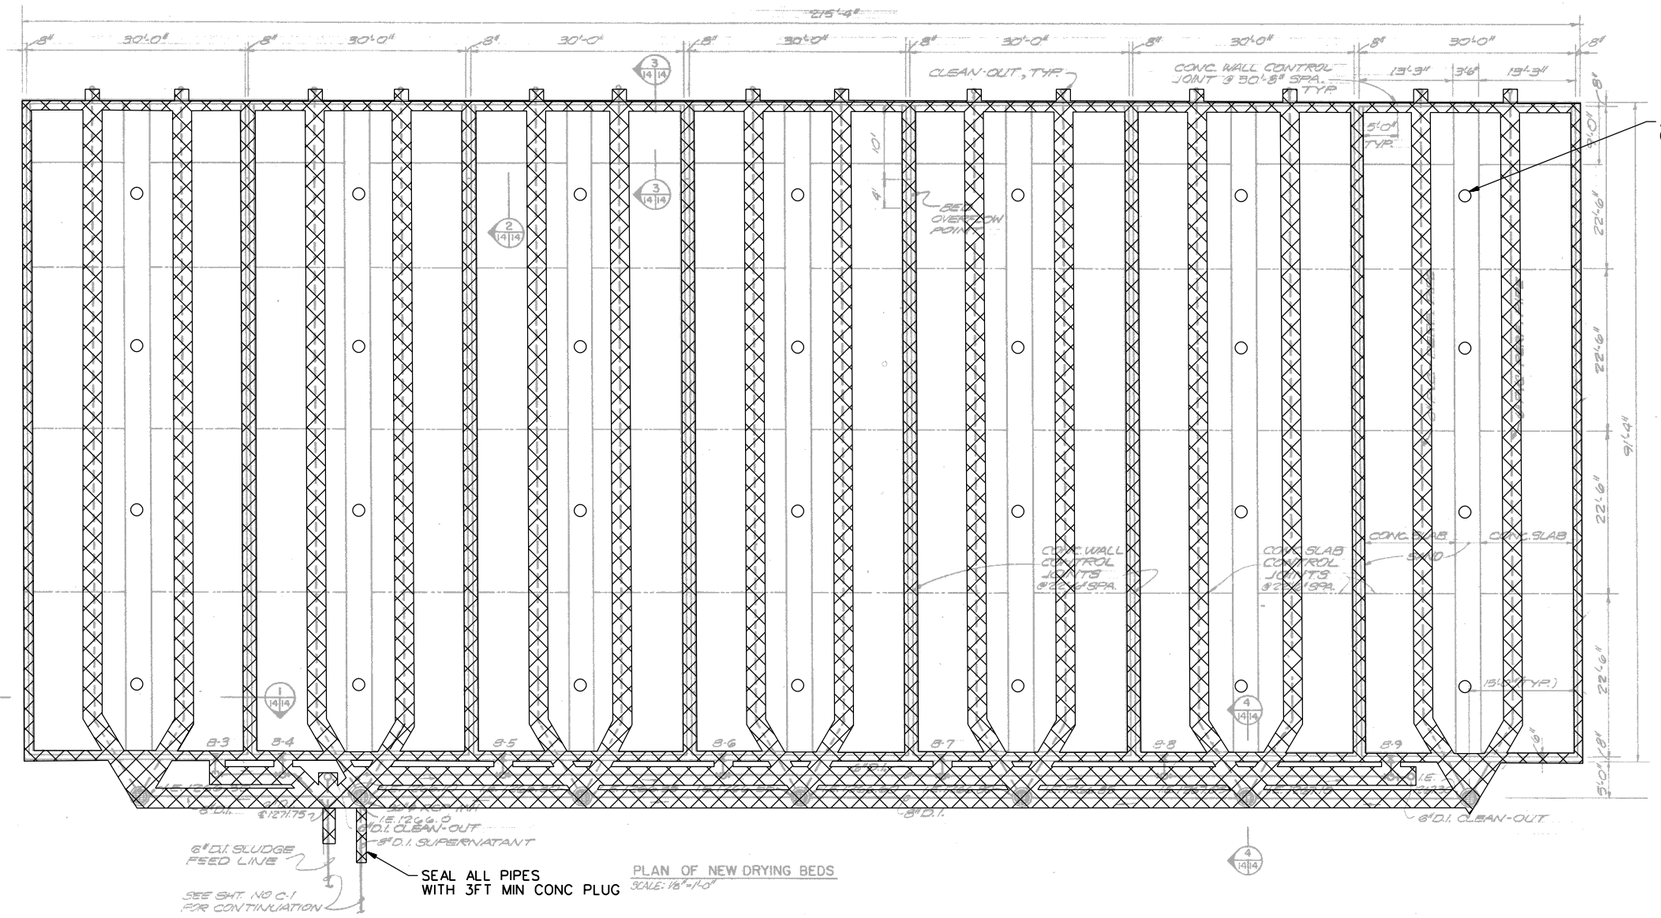

PLAN OF NEW DRYING BEDS
SCALE: 1/8"=1'-0"

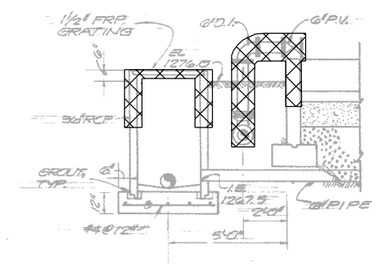

SECTION 4
SCALE: 3/8"=1'-0"

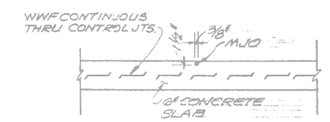

SLAB CONTROL JOINT DETAIL
SCALE: 3/8"=1'-0"

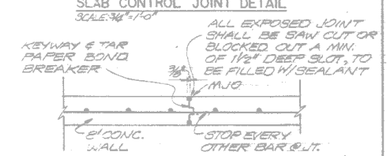

WALL CONTROL JOINT DETAIL
SCALE: 3/8"=1'-0"

GENEPAL CONSTRUCTION NOTE:

1. DRYING BED WALLS SHALL BE BACKFILLED ON EACH SIDE SIMULTANEOUSLY SO THAT MAXIMUM DIFFERENTIAL FILL HEIGHT IS LESS THAN 2'-0" AT ALL TIMES.

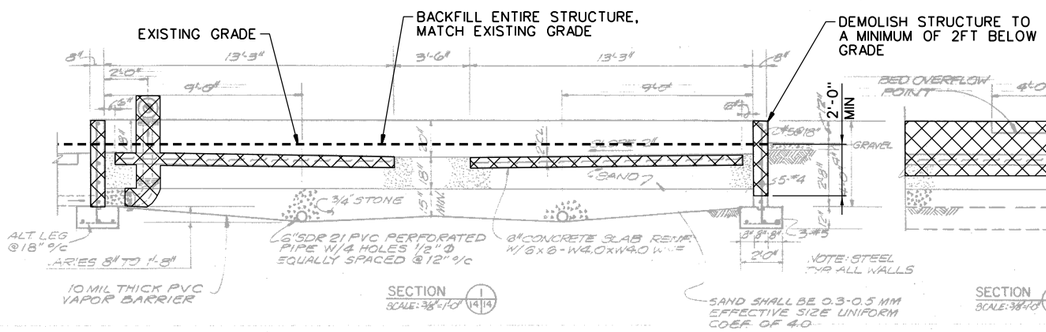

SECTION 1
SCALE: 3/8"=1'-0"

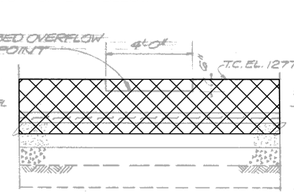

SECTION 2
SCALE: 3/8"=1'-0"

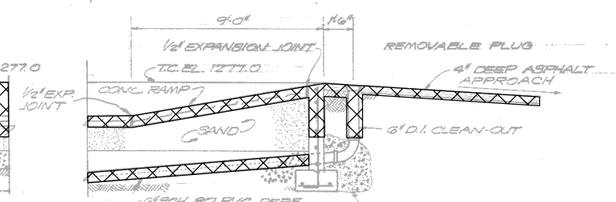

SECTION 3
SCALE: 3/8"=1'-0"

RECORD DRAWING
MARCH 1988
CONTRACT NO. DACA41-84-C-0095

VERIFY SCALES
BAR IS ONE INCH ON ORIGINAL DRAWING.
0 1"
IF NOT ONE INCH ON THIS SHEET, ADJUST SCALES ACCORDINGLY.

SYMBOL	DESCRIPTION	DATE	APPROVAL
	Revised for "As Built" conditions		

REVISIONS

HNTB
HOWARD NEEDLES TAMMEN & BERGENDOFF

DEPARTMENT OF THE ARMY
KANSAS CITY DISTRICT
CORPS OF ENGINEERS
KANSAS CITY, MISSOURI

DESIGNED BY: JTH
DRAWN BY: KAK
CHECKED BY: JDS/JEK
SUBMITTED: ARCHITECT-ENGINEER
APPROVED:

FORT PLEY — KANSAS
SEWAGE TREATMENT FACILITY & WATER SYSTEM UPGRADE
CUSTER HILL SEWAGE TREATMENT PLANT
NEW SLUDGE DRYING BEDS
PLAN, SECTIONS & DETAILS
84-MCA-320

APPROVED: CHIEF, MILITARY BRANCH
DATE: JUL 1984
CHIEF, ENGINEERING DIVISION
SCALE: AS SHOWN
DRAWING NUMBER: 71-07-02
SHEET: C-14

SEQUENCE NO. 38

US Army Corps of Engineers
Kansas City District

H. DOUGLAS YEARSLEY
LICENSED
12525
KANSAS
PROFESSIONAL ENGINEER

VERIFY SCALES
BAR IS ONE INCH ON ORIGINAL DRAWING.
0 1"
IF NOT ONE INCH ON THIS SHEET, ADJUST SCALES ACCORDINGLY.

Work	Description	Date	Appr.	Work	Description	Date	Appr.

Designed by: D. ROBILLARD
Dwn by: R. MARKEN
Ckd by: S. GLCHRST
Reviewed by: BDYERSLEY
Submitted by: S. GLCHRST
Date: JUNE 2002
Design file no.
Drawing code:
File name: H-52-0011.dgn
Plot date: 15-JUL-2002
Plot Time: 08:17:46
Rev.

US Army Corps of Engineers
Kansas City District

CH2MHILL
DENVER, COLORADO

ADVANCED WASTEWATER TREATMENT PLANT AND COLLECTION SYSTEM PUMP STATIONS AND FORCE MAIN
PN 45230
FORT RILEY, KANSAS
OPTIONAL DEMOLITION
TYPICAL DEMOLITION
SLUDGE DRYING BEDS

Sheet reference number:
52-X-8
Sheet 367 of 374