CORPS OF ENGINEERS — U. S. ARMY

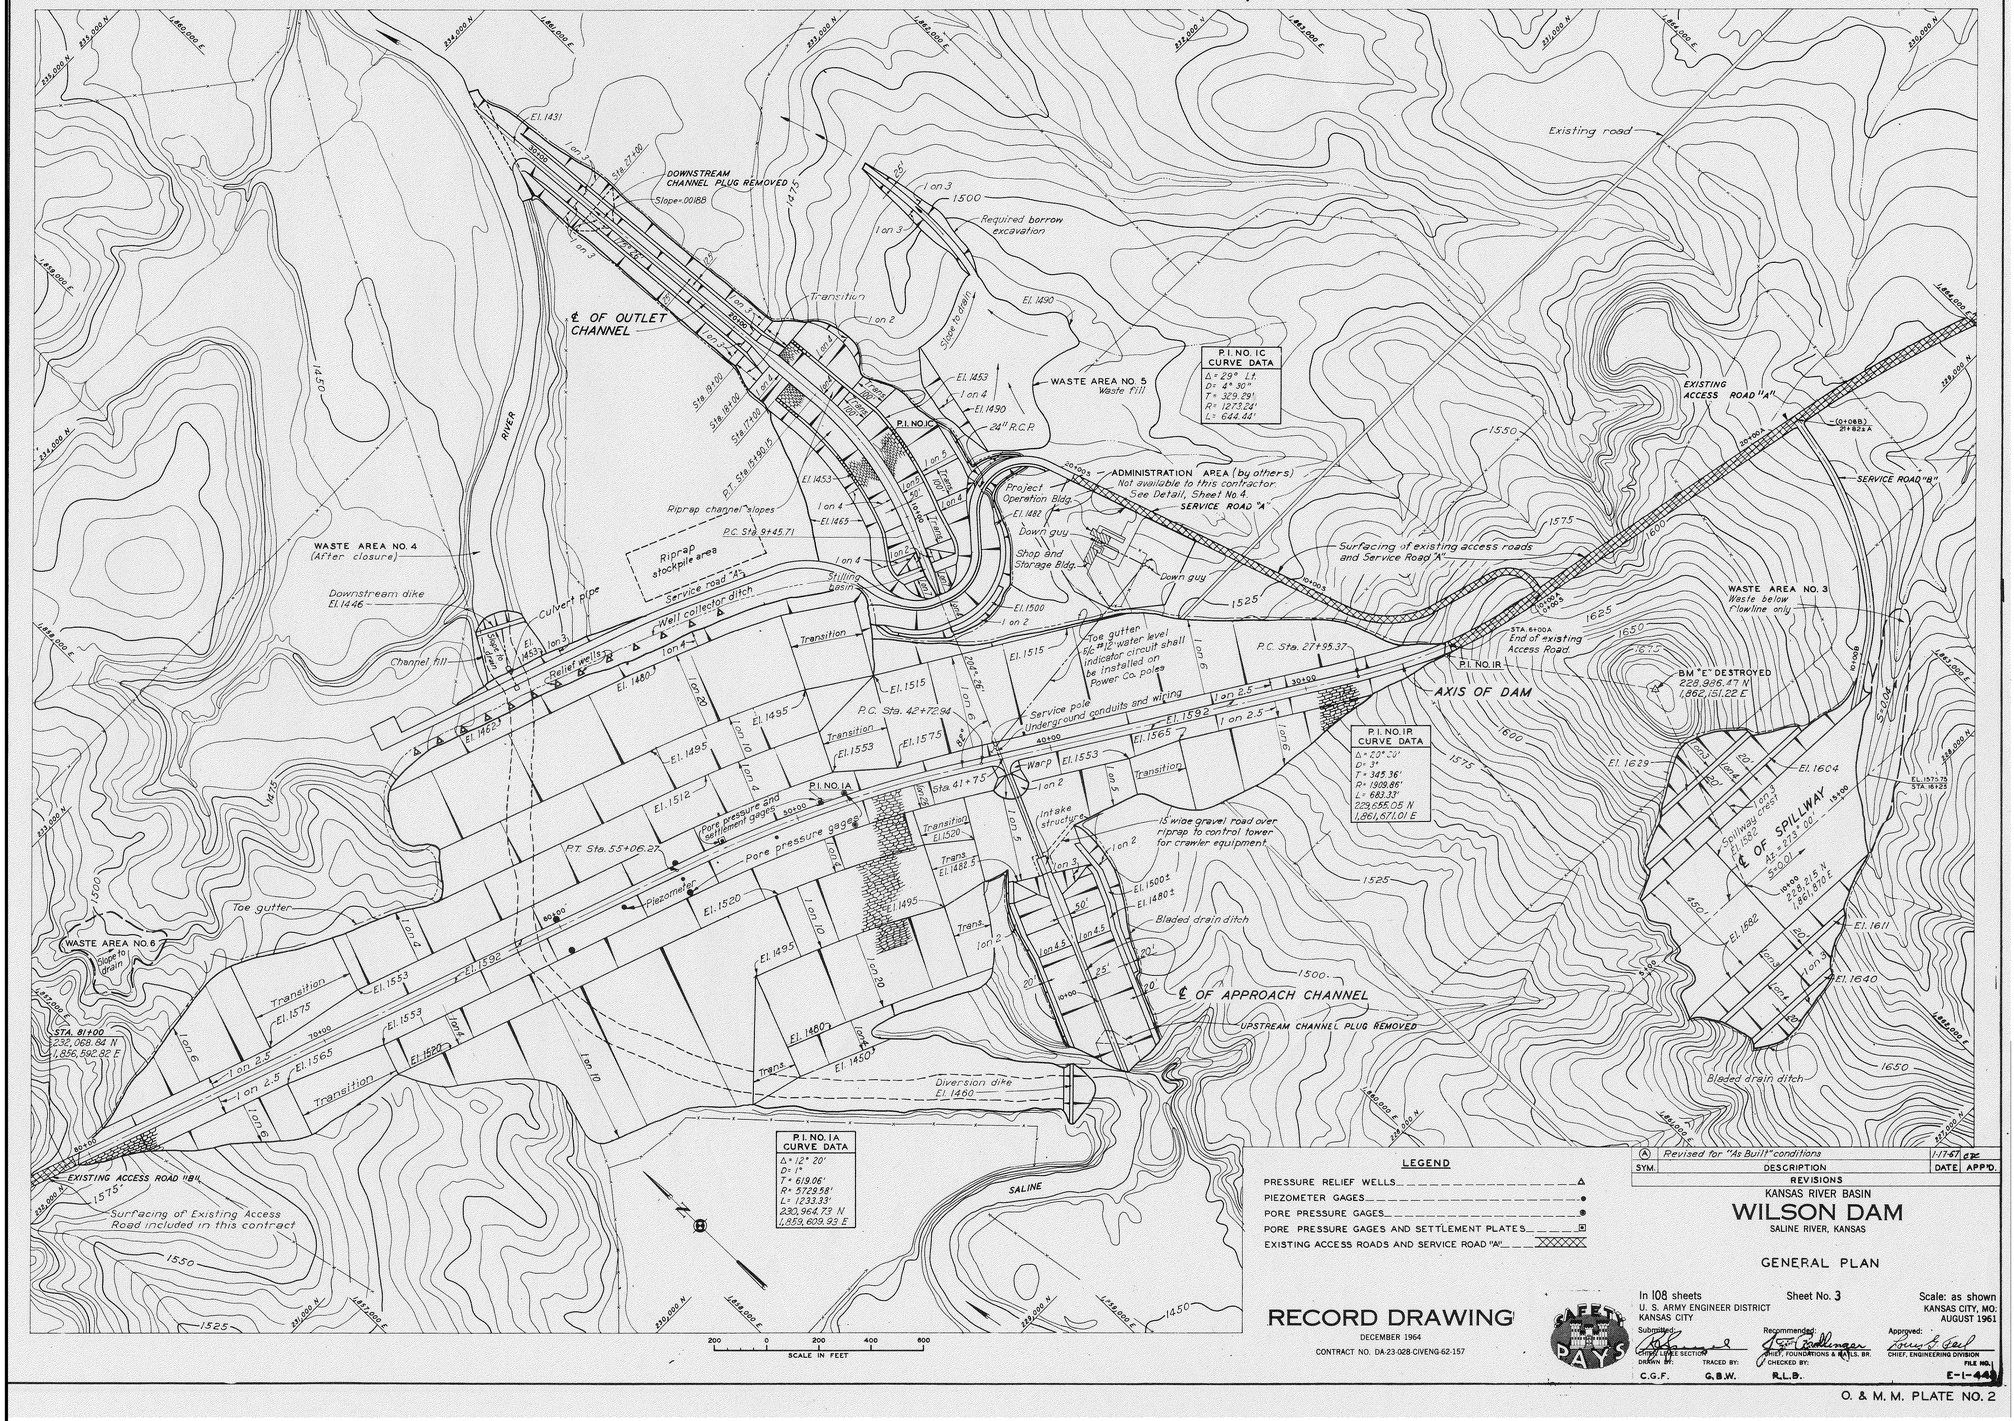

LEGEND

PRESSURE RELIEF WELLS
PIEZOMETER GAGES
PORE PRESSURE GAGES
PORE PRESSURE GAGES AND SETTLEMENT PLATES
EXISTING ACCESS ROADS AND SERVICE ROAD "A"

RECORD DRAWING
DECEMBER 1964
CONTRACT NO. DA-23-028-CIVENG-62-157

SYM.	DESCRIPTION	DATE	APP'D.
A	Revised for "As Built" conditions	1-17-67	GJC

REVISIONS

KANSAS RIVER BASIN

WILSON DAM

SALINE RIVER, KANSAS

GENERAL PLAN

In 108 sheets — Sheet No. 3 — Scale: as shown

U. S. ARMY ENGINEER DISTRICT
KANSAS CITY

Submitted: Chief, Civil Works Section
Recommended: Chief, Foundations & Materials Br.
Approved: Chief, Engineering Division

DRAWN BY: C.G.F. — TRACED BY: G.B.W. — CHECKED BY: R.L.B.

KANSAS CITY, MO. AUGUST 1961

FILE NO. E-1-441

O. & M. M. PLATE NO. 2

US Army Corps of Engineers
Kansas City District

Symbol	Description	Date	Appr

Designed by: H.T.Y. — Date: APRIL 2004 — Rev.
Drawn by: H.T.Y. — Ckd by: R.S.K. — Design file no. E-1-1680
Reviewed by: — Drawing code:
Submitted by: D.L.M. — File name WIW001.DGN — Plot date= — Plot scale= .0833333'

U.S. ARMY ENGINEER DISTRICT
CORPS OF ENGINEERS
KANSAS CITY, MISSOURI

SALINE RIVER, KANSAS
WILSON LAKE
STILLING BASIN WALL REPAIR

GENERAL PLAN

Sheet reference number: I-1

FOR INFORMATION ONLY