CORPS OF ENGINEERS

U. S. ARMY

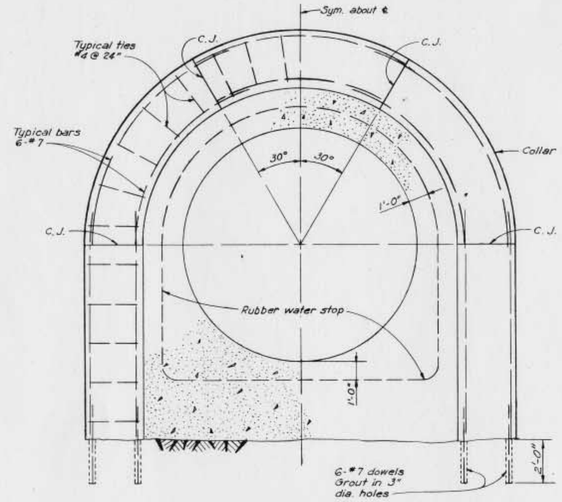

SECTION SHOWING COLLAR AND WATER STOP
Scale: 3/8" = 1'-0"

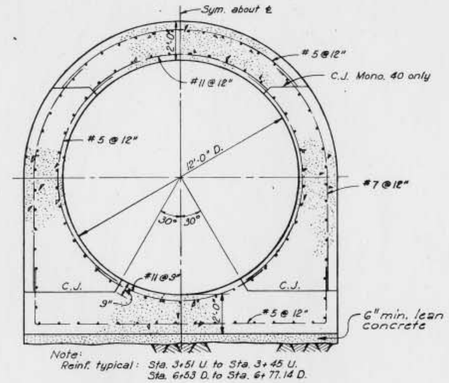

Ⓑ SECTION A-A
Scale: 3/8" = 1'-0"

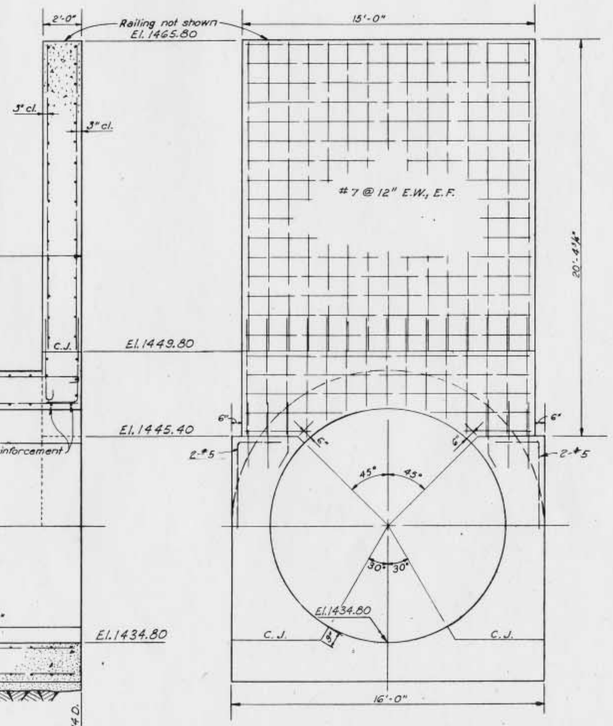

Ⓐ ELEVATION
Scale: 3/8" = 1'-0"

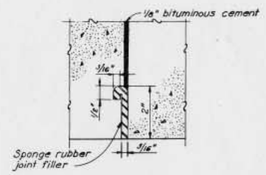

DETAIL "A"
Half size

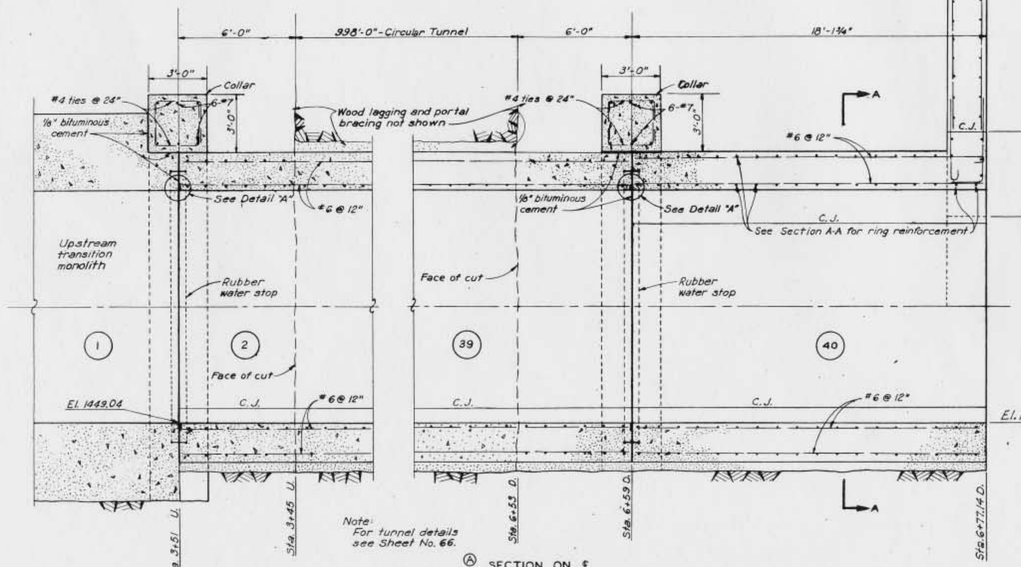

Note:
For tunnel details see Sheet No. 66.

Ⓐ SECTION ON ℄
Scale: 3/8" = 1'-0"

Notes:
For "General Notes" see Sheet No. 23.
For detail of rubber water stop see Sheet No. 83.
For detail of railing on headwall see Sheet No. 70.

RECORD DRAWING

DECEMBER 1964

CONTRACT NO. DA-23-028-CIVENG-62-157

SYM.	DESCRIPTION	DATE	APP'D.
Ⓒ	Revised for "As Built" conditions	1-17-67	RJK
Ⓑ	Change as per Addendum No. 4	4-11-63	RJK
Ⓐ	Elevation changes.	4-11-63	RJK

REVISIONS

KANSAS RIVER BASIN

WILSON DAM

SALINE RIVER, KANSAS

OUTLET WORKS
TUNNEL
END MONOLITH AND DOWNSTREAM HEADWALL

In 108 sheets — Sheet No. 67 — Scale: as shown

U. S. ARMY ENGINEER DISTRICT
KANSAS CITY

KANSAS CITY, MO.
AUGUST 1961

Submitted: Earl B. Cohn — CHIEF, STRUCTURAL SECTION
Recommended: R. T. Miller — CHIEF, DESIGN BRANCH
Approved: Louis J. Feil — CHIEF, ENGINEERING DIVISION

DRAWN BY: E.N.E. — TRACED BY: F.C.L. — CHECKED BY: M.M.H. — FILE NO. E-1-507

O. & M. M. PLATE NO. 72

FOR INFORMATION ONLY

US Army Corps of Engineers
Kansas City District

Symbol	Description	Date	Appr.

Designed by: H.T.Y.
Dwn by: H.T.Y.
Ckd by: R.S.K.
Reviewed by:
Submitted by: D.L.M.
Date: APRIL 2004
Design file no. E-1-1685
Drawing code:
File name: WIW006.DGN
Plot date:
Plot scale: 0.833333:1
Rev.

U.S. ARMY ENGINEER DISTRICT
CORPS OF ENGINEERS
KANSAS CITY, MISSOURI

SALINE RIVER, KANSAS
WILSON LAKE
STILLING BASIN WALL REPAIR

OUTLET WORKS
TUNNEL END MONOLITH
AND DOWNSTREAM HEADWALL

Sheet reference number:
I-6