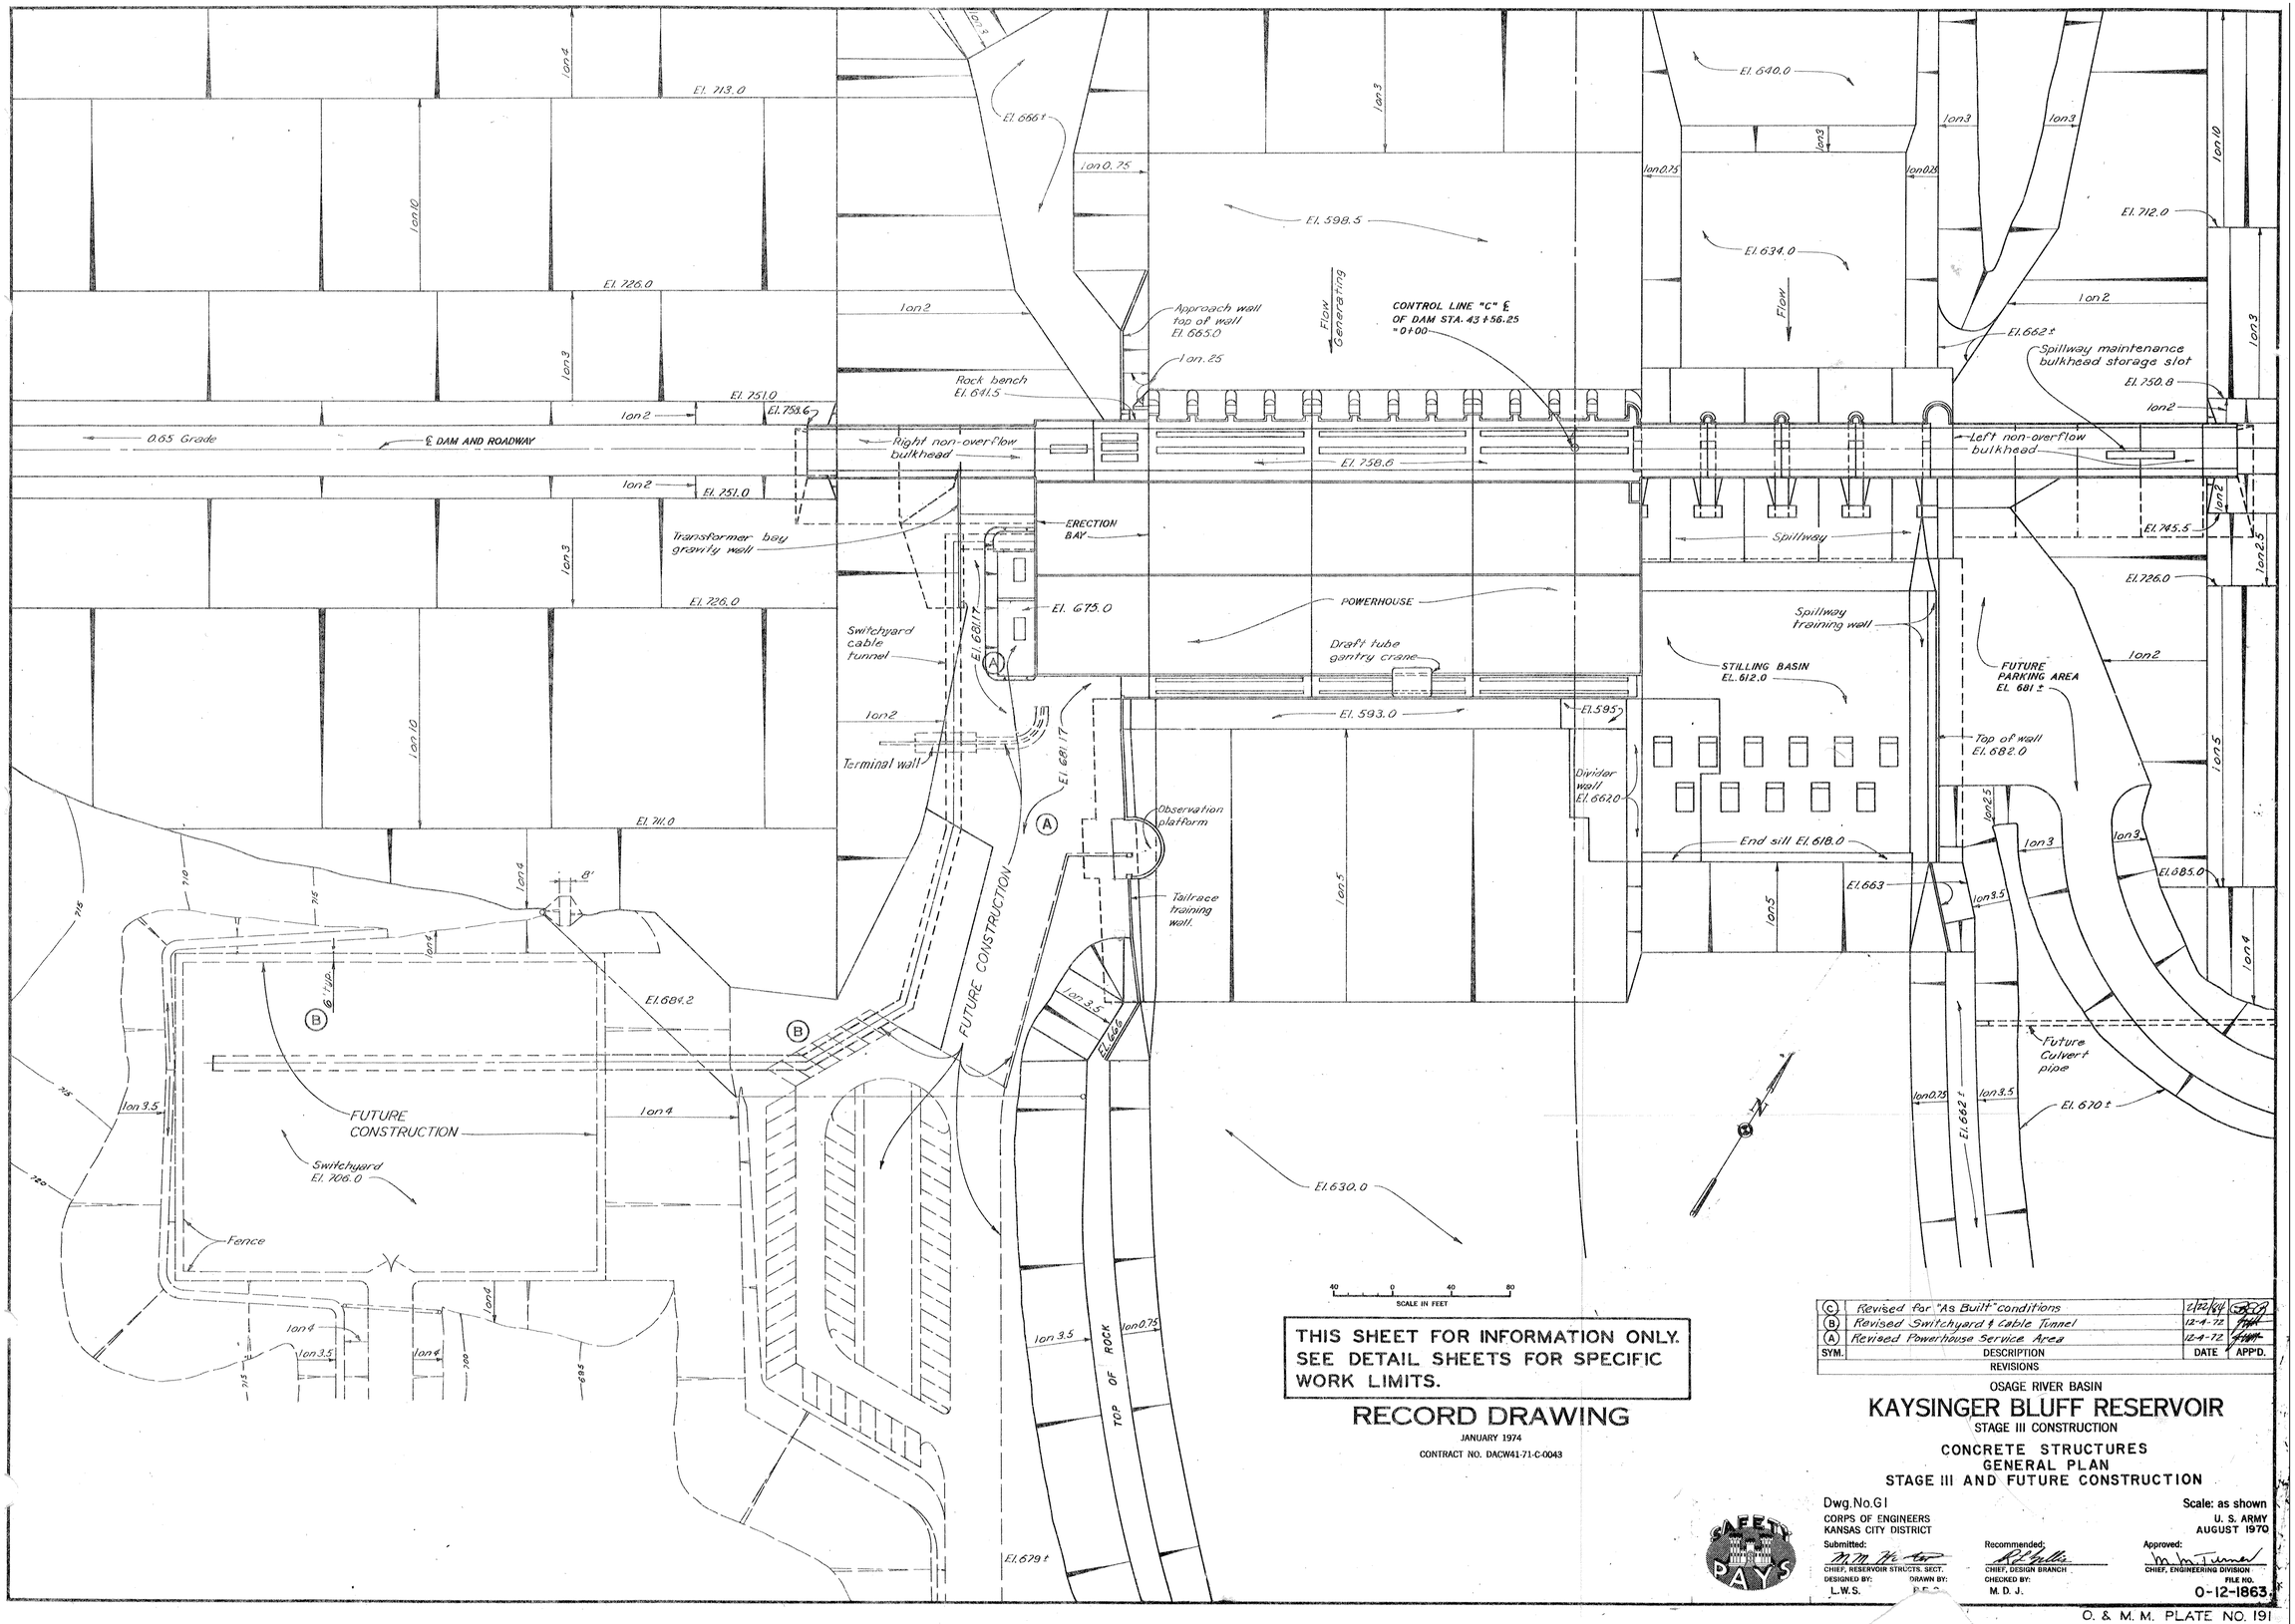

SYM.	DESCRIPTION	DATE	APP'D.
	REVISIONS		
C	Revised for "As Built" conditions	2/22/74	
B	Revised Switchyard & Cable Tunnel	12-4-72	
A	Revised Powerhouse Service Area	12-4-72	

OSAGE RIVER BASIN

KAYSINGER BLUFF RESERVOIR

STAGE III CONSTRUCTION

CONCRETE STRUCTURES GENERAL PLAN STAGE III AND FUTURE CONSTRUCTION

Dwg. No. G1

Scale: as shown

CORPS OF ENGINEERS
KANSAS CITY DISTRICT

U. S. ARMY
AUGUST 1970

Submitted: CHIEF, RESERVOIR STRUCTS. SECT.

Recommended: CHIEF, DESIGN BRANCH

Approved: CHIEF, ENGINEERING DIVISION

DESIGNED BY: L.W.S.

DRAWN BY:

CHECKED BY: M. D. J.

FILE NO. 0-12-1863

O. & M. M. PLATE NO. 191