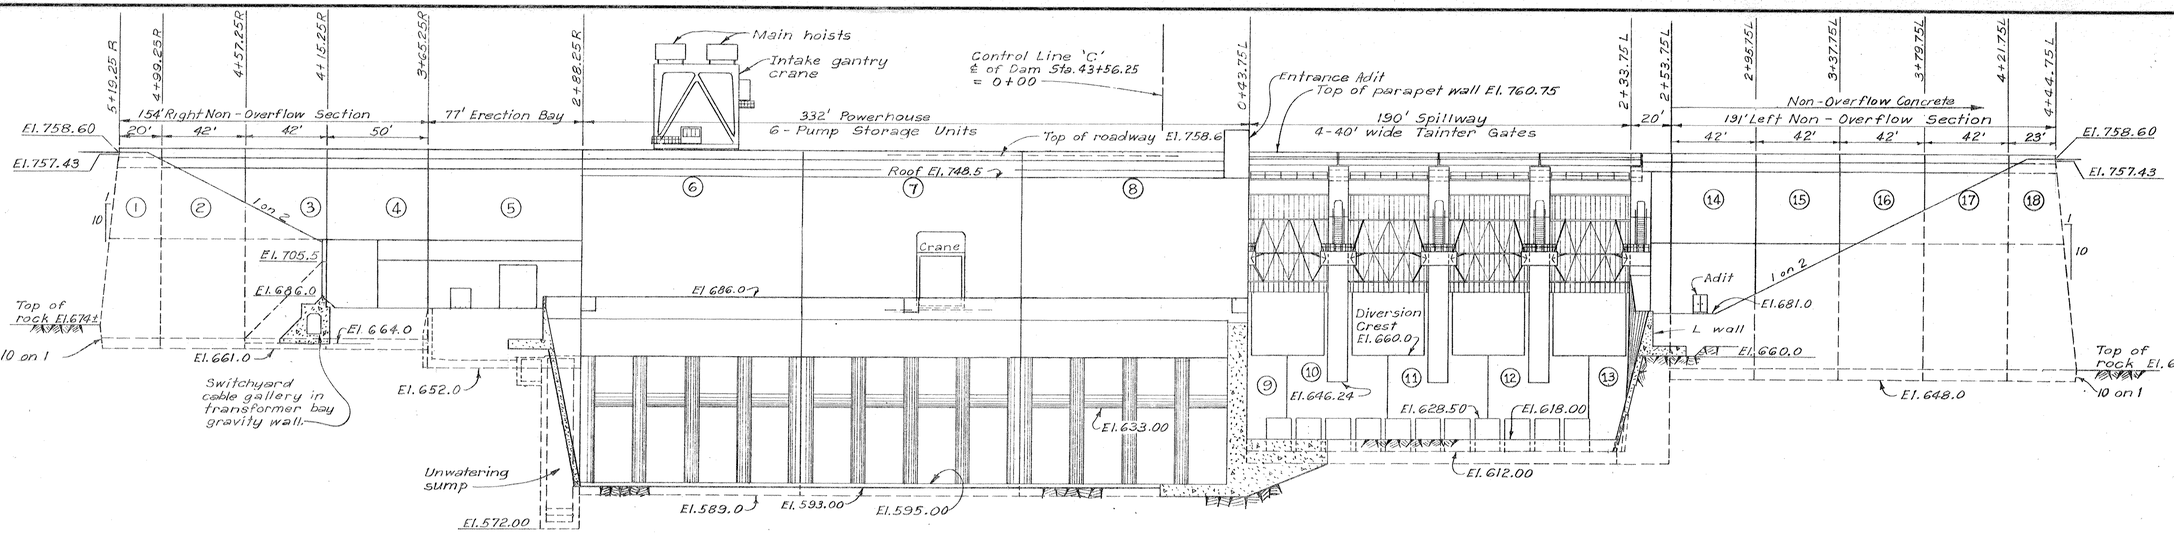

DOWNSTREAM ELEVATION
Scale: 1" = 30'

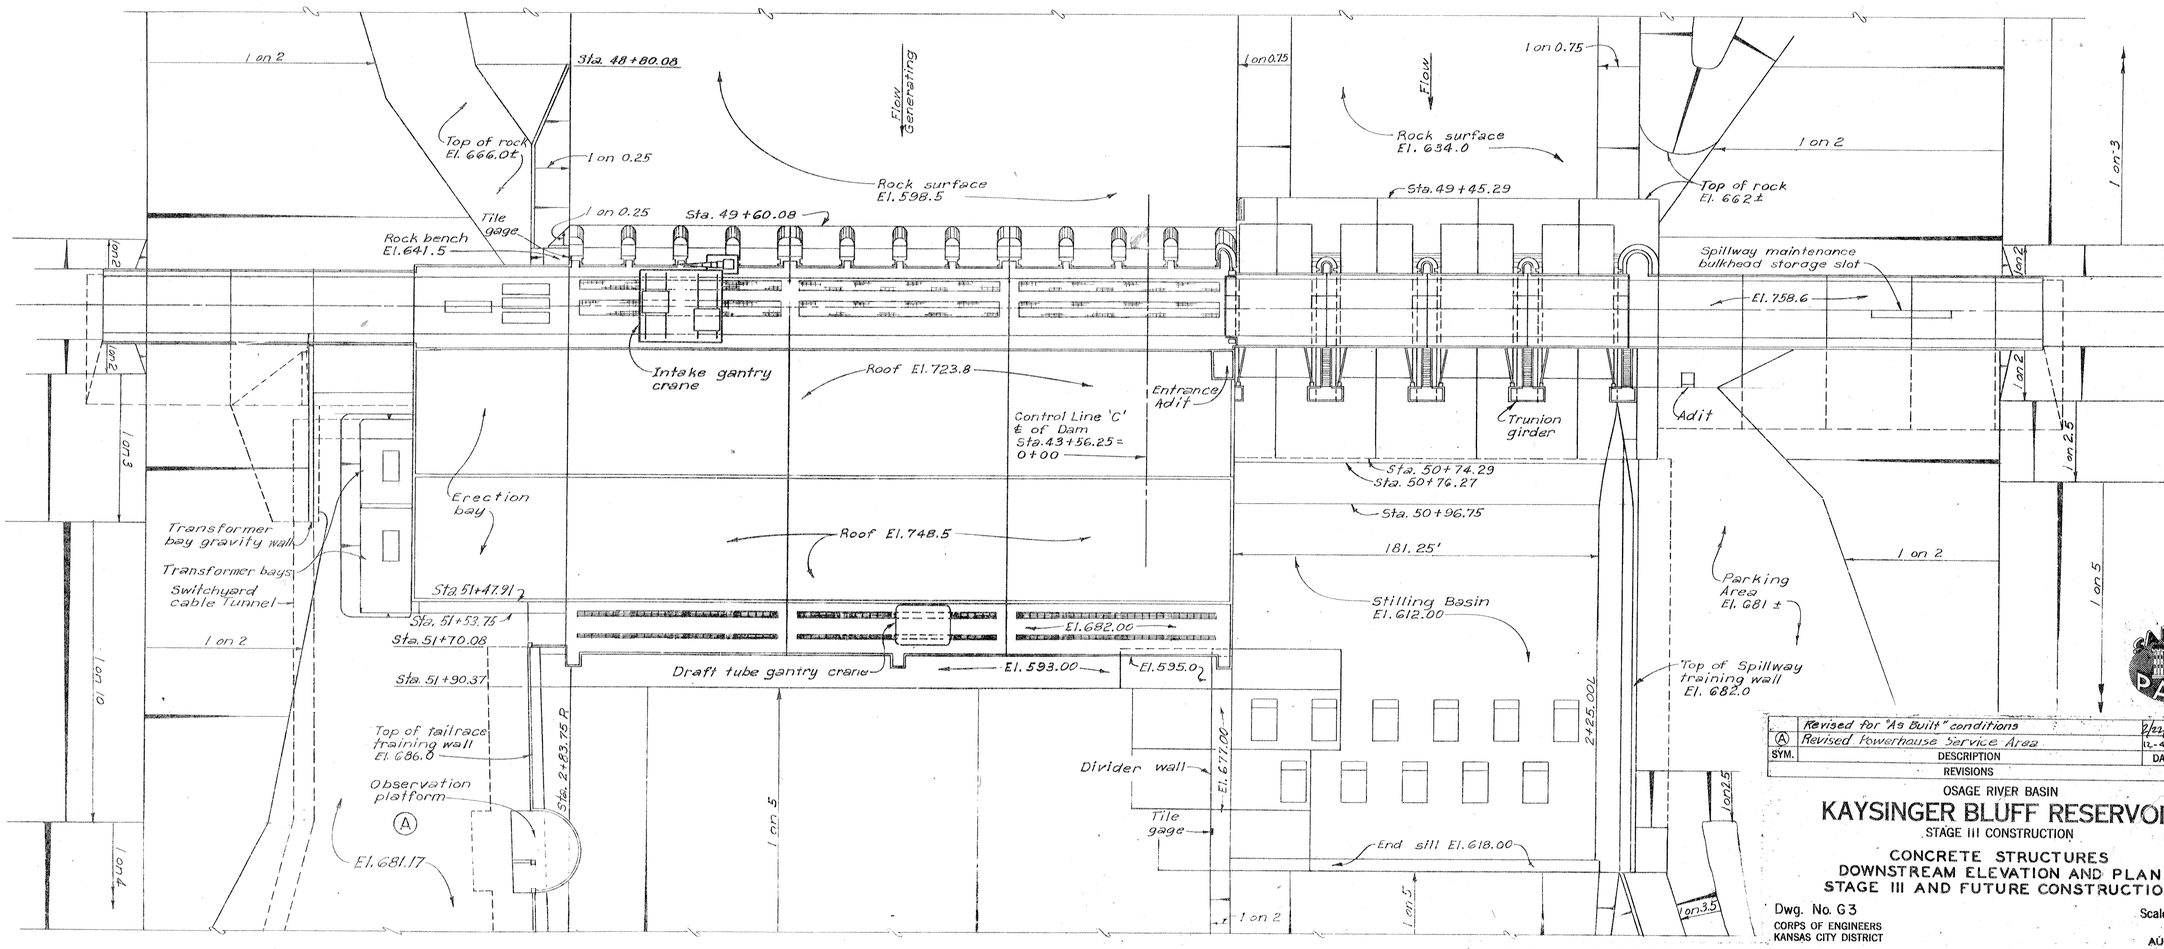

PLAN
Scale: 1" = 50'

RECORD DRAWING
JANUARY 1974
CONTRACT NO. DACW41-71-C-0043

SYM.	DESCRIPTION	DATE	APP'D.
	Revised for "As Built" conditions	2/22/91	
(A)	Revised Powerhouse Service Area	12-4-73	

REVISIONS

OSAGE RIVER BASIN
KAYSINGER BLUFF RESERVOIR
STAGE III CONSTRUCTION

CONCRETE STRUCTURES
DOWNSTREAM ELEVATION AND PLAN
STAGE III AND FUTURE CONSTRUCTION

Dwg. No. G3
CORPS OF ENGINEERS
KANSAS CITY DISTRICT

Scale: 1" = 30'
U. S. ARMY
AUGUST 1970

Submitted: CHIEF, RESERVOIR STRUCTS. SECT.
Recommended: CHIEF, DESIGN BRANCH
Approved: CHIEF, ENGINEERING DIVISION

DESIGNED BY: M.D.J. DRAWN BY: J.A.R. CHECKED BY: M.D.J.

FILE NO. 0-12-1865

O. & M. M. PLATE NO. 193