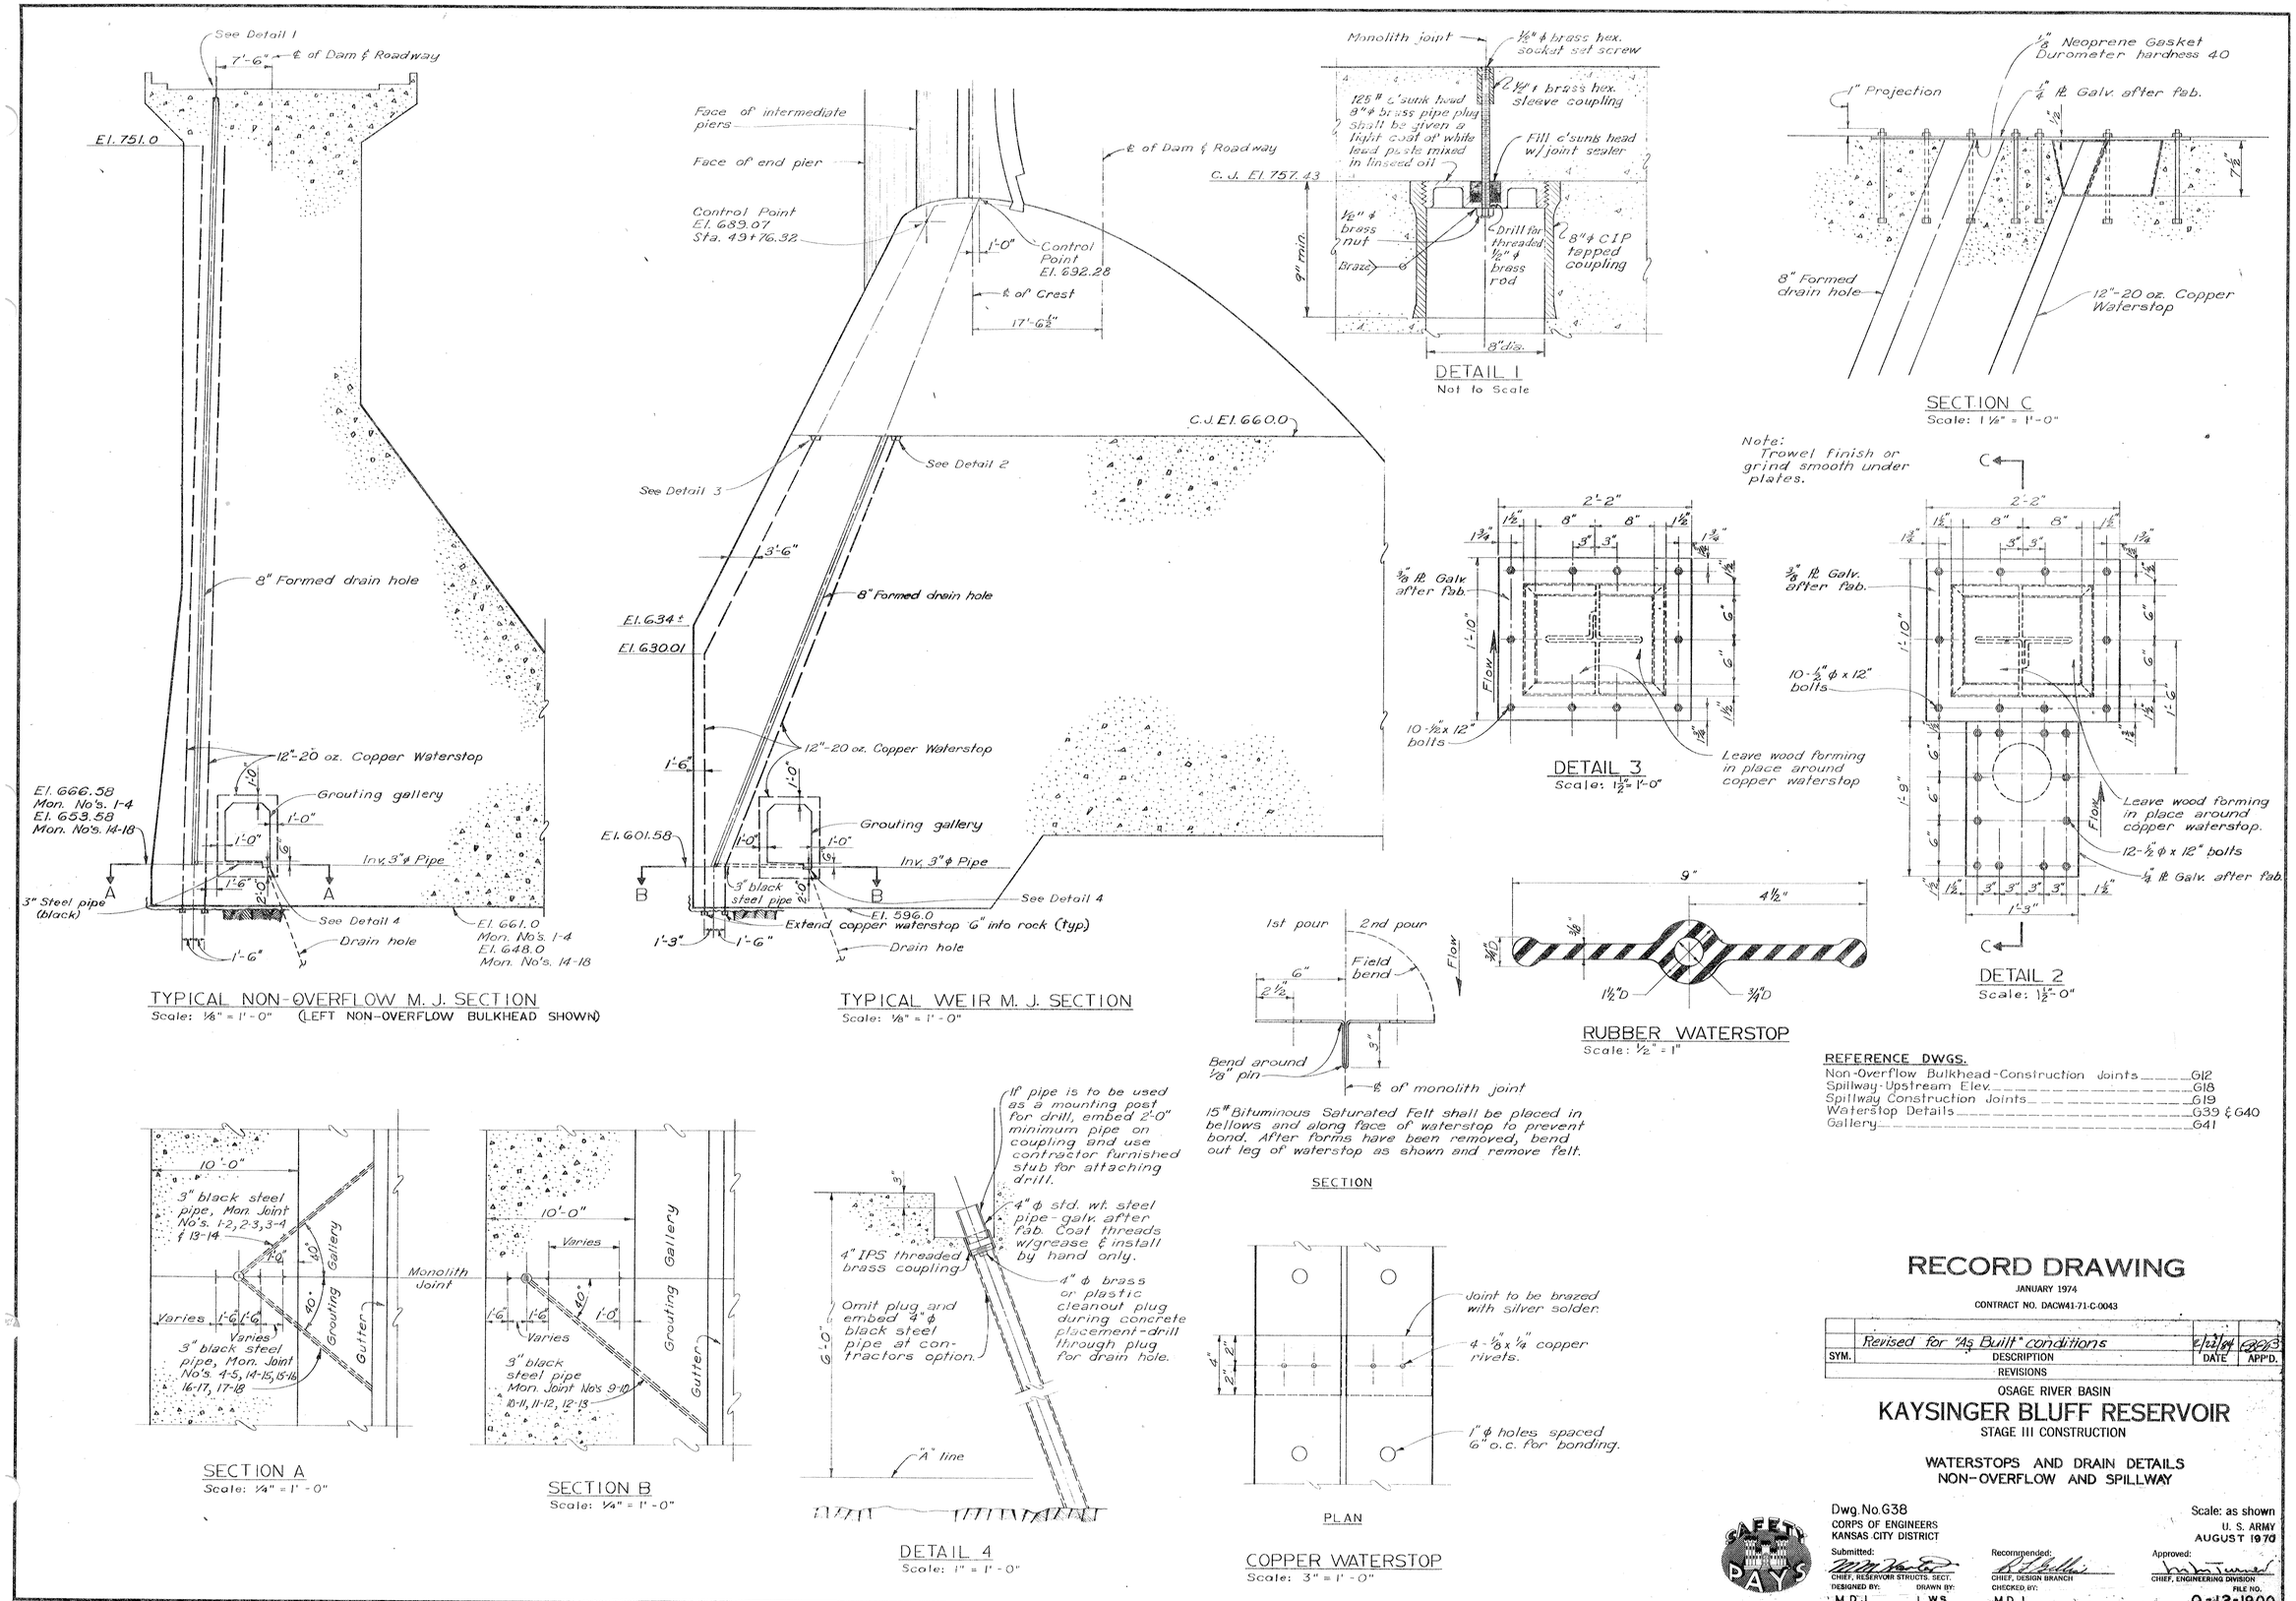

RECORD DRAWING

JANUARY 1974

CONTRACT NO. DACW41-71-C-0043

SYM.	DESCRIPTION	DATE	APP'D.
	Revised for "As Built" conditions	6/22/84	GBB

REVISIONS

OSAGE RIVER BASIN

KAYSINGER BLUFF RESERVOIR

STAGE III CONSTRUCTION

WATERSTOPS AND DRAIN DETAILS
NON-OVERFLOW AND SPILLWAY

Dwg. No. G38
CORPS OF ENGINEERS
KANSAS CITY DISTRICT

Scale: as shown
U. S. ARMY
AUGUST 1970

Submitted: CHIEF, RESERVOIR STRUCTS. SECT.
Recommended: CHIEF, DESIGN BRANCH
Approved: CHIEF, ENGINEERING DIVISION

DESIGNED BY: M.D.J. DRAWN BY: L.W.S. CHECKED BY: M.D.J.

FILE NO. O-12-1900

O. & M. M. PLATE NO. 226