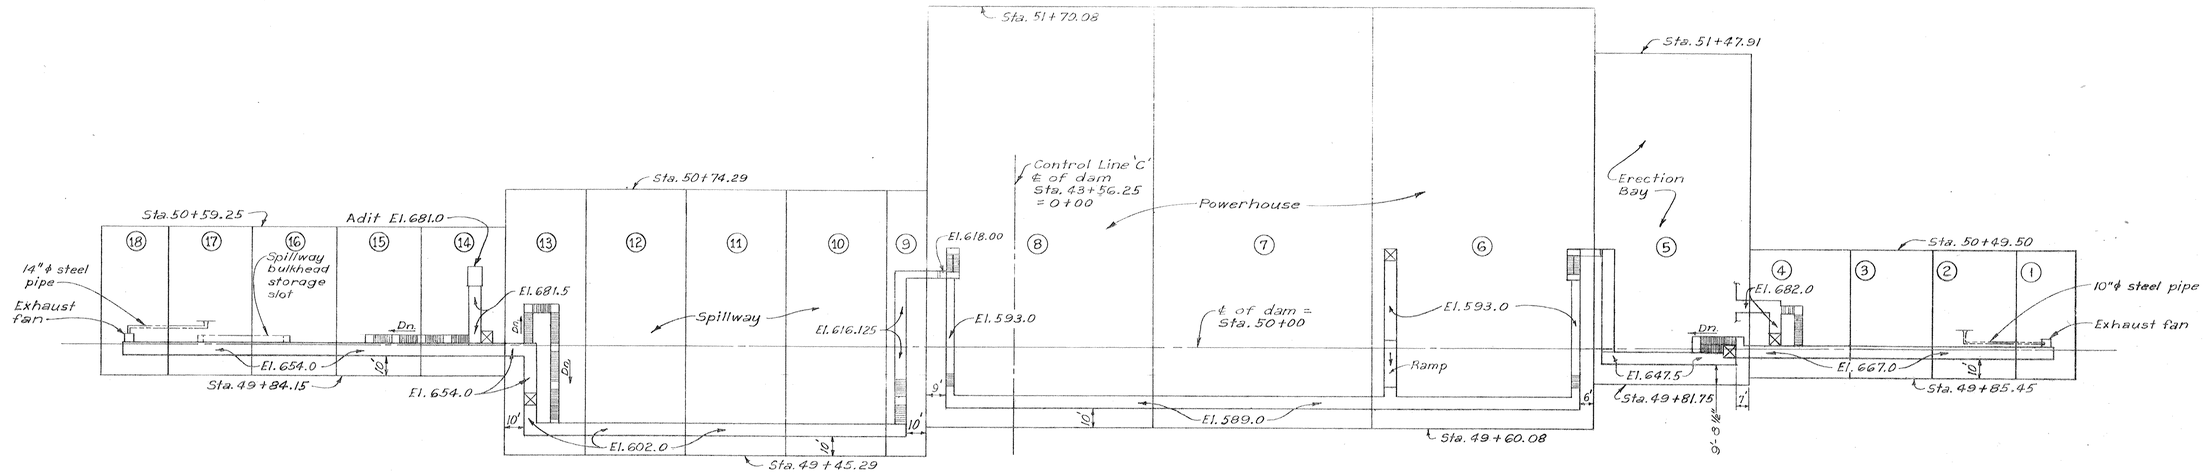

PLAN OF GALLERIES

Scale: 1" = 30'-0"

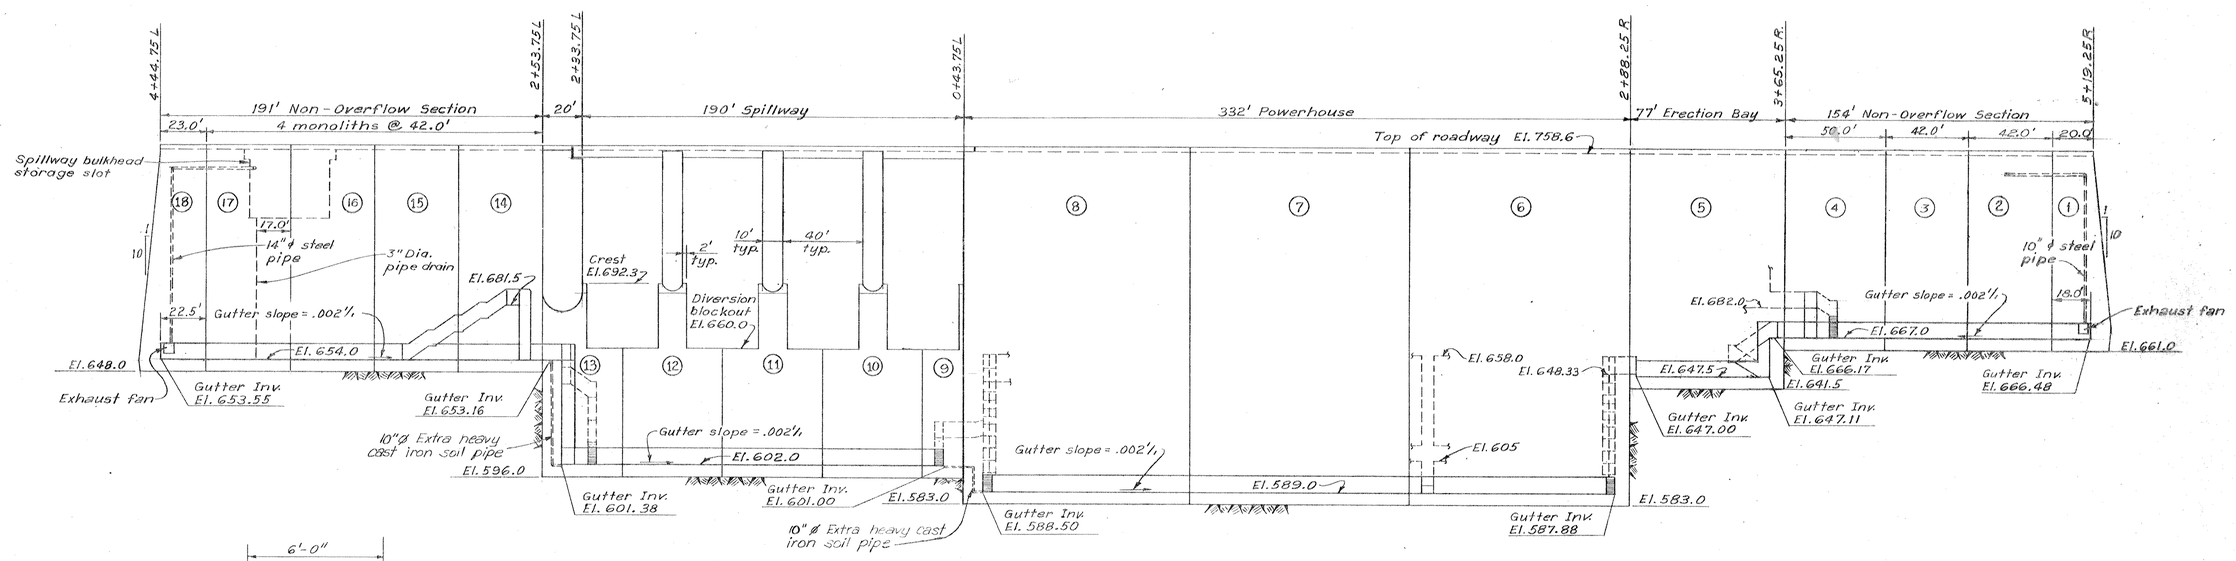

PROFILE OF GALLERIES

Scale: 1" = 30'-0"

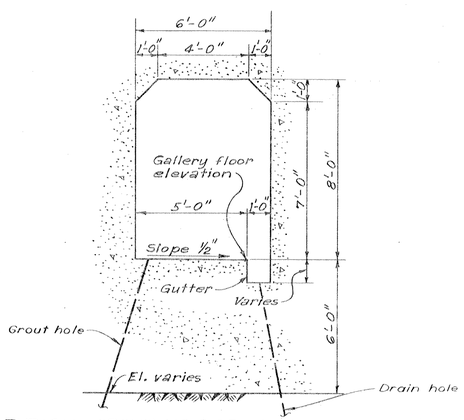

TYPICAL GROUTING & DRAINAGE GALLERY

Scale: 3/8" = 1'-0"

GENERAL NOTES – GALLERIES

All exposed edges of concrete shall be chamfered ¾" unless otherwise noted.

Concrete dimensions and reinforcement clearance are to "A" line of excavation.

CJ – Construction joint with reinforcement continuous thru joint unless otherwise shown.

MJ – Monolith joint with reinforcement not continuous thru joint.

All gratings and railings shall be galvanized after fabrication.

REFERENCE DWGS.

Non-Overflow Bulkheads	G11
Spillway	G18
Waterstops & drains	G38, G39
Electrical	G48

RECORD DRAWING

JANUARY 1974

CONTRACT NO. DACW41-71-C-0043

SYM.	DESCRIPTION	DATE	APP'D.
	Revised for "As Built" conditions	[illegible]	[illegible]

REVISIONS

OSAGE RIVER BASIN

KAYSINGER BLUFF RESERVOIR

STAGE III CONSTRUCTION

GALLERIES GENERAL LAYOUT

Dwg. No. G41

CORPS OF ENGINEERS
KANSAS CITY DISTRICT

Submitted: CHIEF, RESERVOIR STRUCTS. SECT.

Recommended: CHIEF, DESIGN BRANCH

Approved: CHIEF, ENGINEERING DIVISION

DESIGNED BY: M.D.J. DRAWN BY: J.A.R. CHECKED BY: M.D.J.

Scale: as shown

U. S. ARMY

AUGUST 1970

SAFETY PAYS