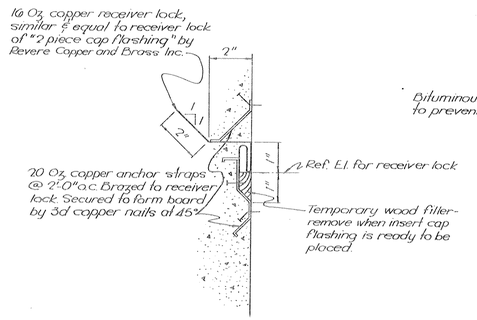

TYPICAL RECEIVER LOCK DETAIL

SCALE: 6 INCHES = 1 FOOT

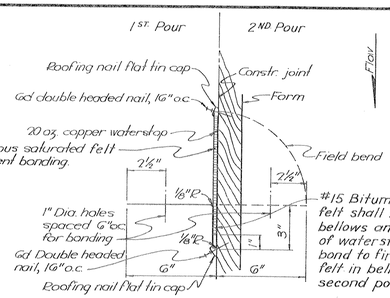

COPPER WATERSTOP - TYPE A

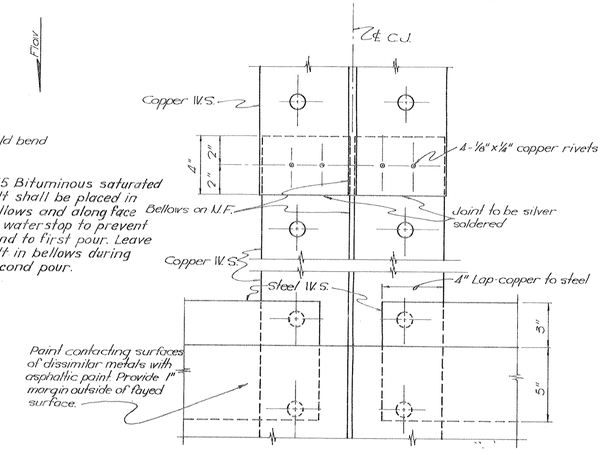

WATERSTOP - COPPER TO COPPER AND COPPER TO STEEL

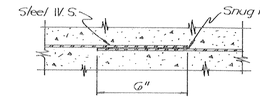

STEEL WATERSTOP

WATERSTOP SPLICE DETAILS

SCALE: 3 INCHES = 1 FOOT

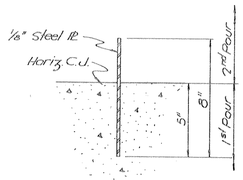

STEEL WATERSTOP

WATERSTOP DETAIL

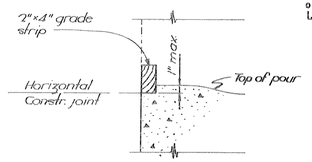

HORIZONTAL FLUSH JOINT

SCALE: 1½ INCHES = 1 FOOT

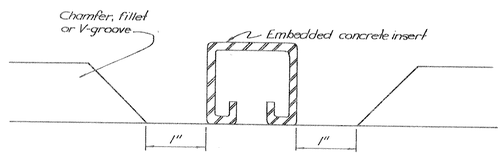

EMBEDDED CONCRETE INSERT

FULL SIZE

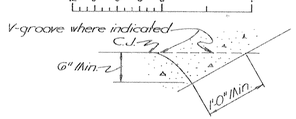

CONSTRUCTION JOINT

AT SLOPING SURFACE

SCALE: 1 INCH = 1 FOOT

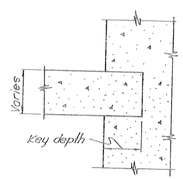

SLAB, BEAM OR WALL

TYPICAL KEY DETAIL

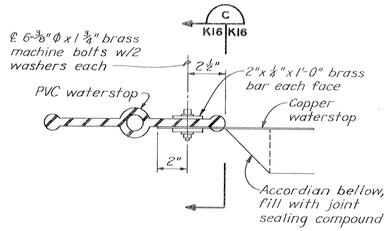

SECTION B K16 K16

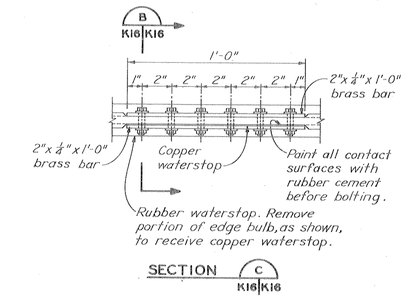

SECTION C K16 K16

COPPER & RUBBER WATERSTOP JUNCTION DETAILS

SCALE: ¼ INCH = 1 FOOT

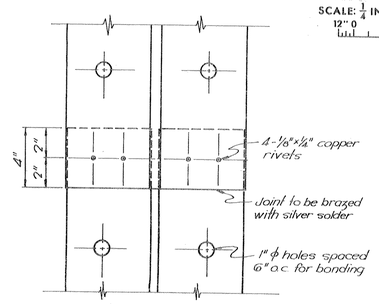

PLAN

COPPER WATERSTOP

SCALE: 3 INCHES = 1 FOOT

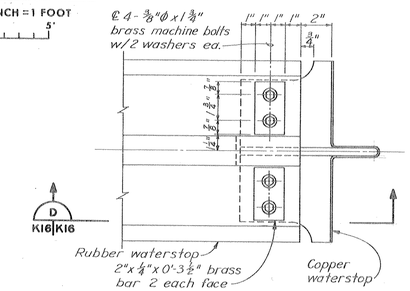

PLAN

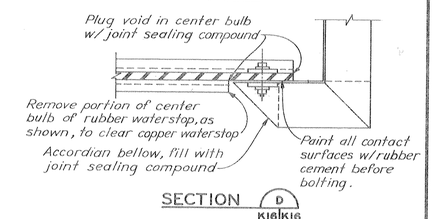

SECTION D K16 K16

HORIZ. RUBBER WATERSTOP TO VERTICAL COPPER WATERSTOP CONNECTION DETAILS

SCALE: 3 INCHES = 1 FOOT

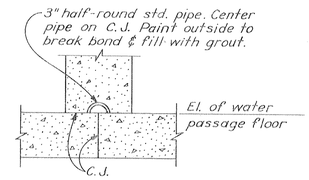

SLAB JOINT

CRACK CONTROL DETAIL

NO SCALE

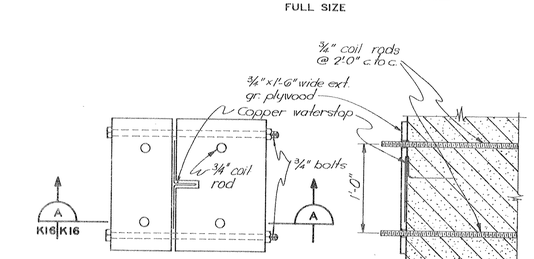

EXPOSED STUB

EXPOSED FLANGE

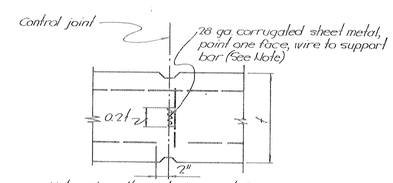

Note: Stop alternate horizontal bars of each face at all control joints. Corrugated metal parting strip in walls 2'-0" and over in thickness only.

CONTROL JOINT DETAIL

NO SCALE

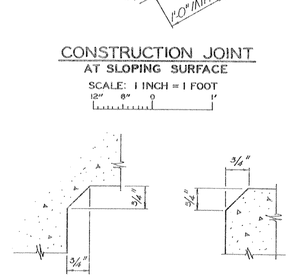

RE-ENTRANT CORNER

EXTERNAL CORNER

CHAMFER DETAILS

TYP. UNLESS OTHERWISE NOTED

SCALE: 6 INCHES = 1 FOOT

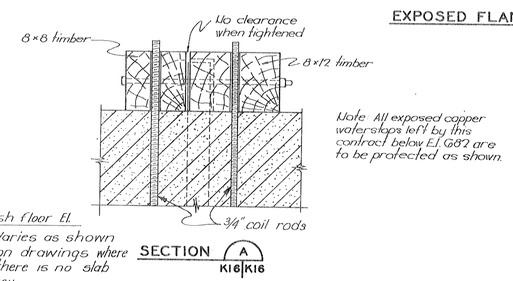

SECTION A K16 K16

WATERSTOP PROTECTION

NO SCALE

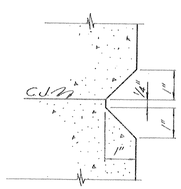

V-GROOVE DETAIL

SCALE: 6 INCHES = 1 FOOT

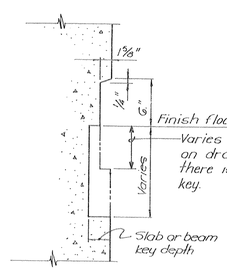

TYPICAL COVE BASE DETAIL

NO SCALE

NOTES:

1. Pour numbers are for identification only and do not necessarily represent sequence of pours.
2. VACANT.
3. Waterstops are to be continuous. For typical splice details see this drawing.
4. Provide ⅛" R. tooled edges for all interior joints & ¼" R. for exposed edges of unformed surfaces where finish is required.
5. Provide chamfer for all corners. See details this dwg.
6. Provide fillets in all re-entrant corners except at construction joints & junctions between wall & floor surfaces.
7. All visible construction jts. except in water passages shall have V-groove, see detail this dwg.
8. Refer to Vol. I, Sec. For gage & test equipment locations.
9. Waterstops in vertical joints are 12" copper & in horizontal joints are 8" steel except as otherwise noted.

SYM.	DESCRIPTION	DATE	APP'D.
	Revised for "As Built" conditions	2/22/83	[illegible]

REVISIONS

RECORD DRAWING

JANUARY 1974

CONTRACT NO. DACW41-71-C-0043

OSAGE RIVER

KAYSINGER BLUFF RESERVOIR

STAGE III CONSTRUCTION

POWERHOUSE SUBSTRUCTURE

STANDARD DETAILS

Dwg. No. K16 — Scale: as shown

U. S. ARMY ENGINEER DISTRICT, KANSAS CITY, MO. — AUG. 1970

PREPARED BY U. S. ARMY ENGINEER DISTRICT, OMAHA, NEBRASKA

Submitted: CHIEF, DESIGN BRANCH USED OMAHA — Recommended: CHIEF, DESIGN BRANCH USED KANSAS CITY — Approved: CHIEF, ENGINEERING DIVISION USED KANSAS CITY

DESIGNED BY: DRAWN BY: A. G. D. — CHECKED BY: J. O. C. — FILE NO. 0-12-2016

SAFETY PAYS

O. & M. M. PLATE NO. 326