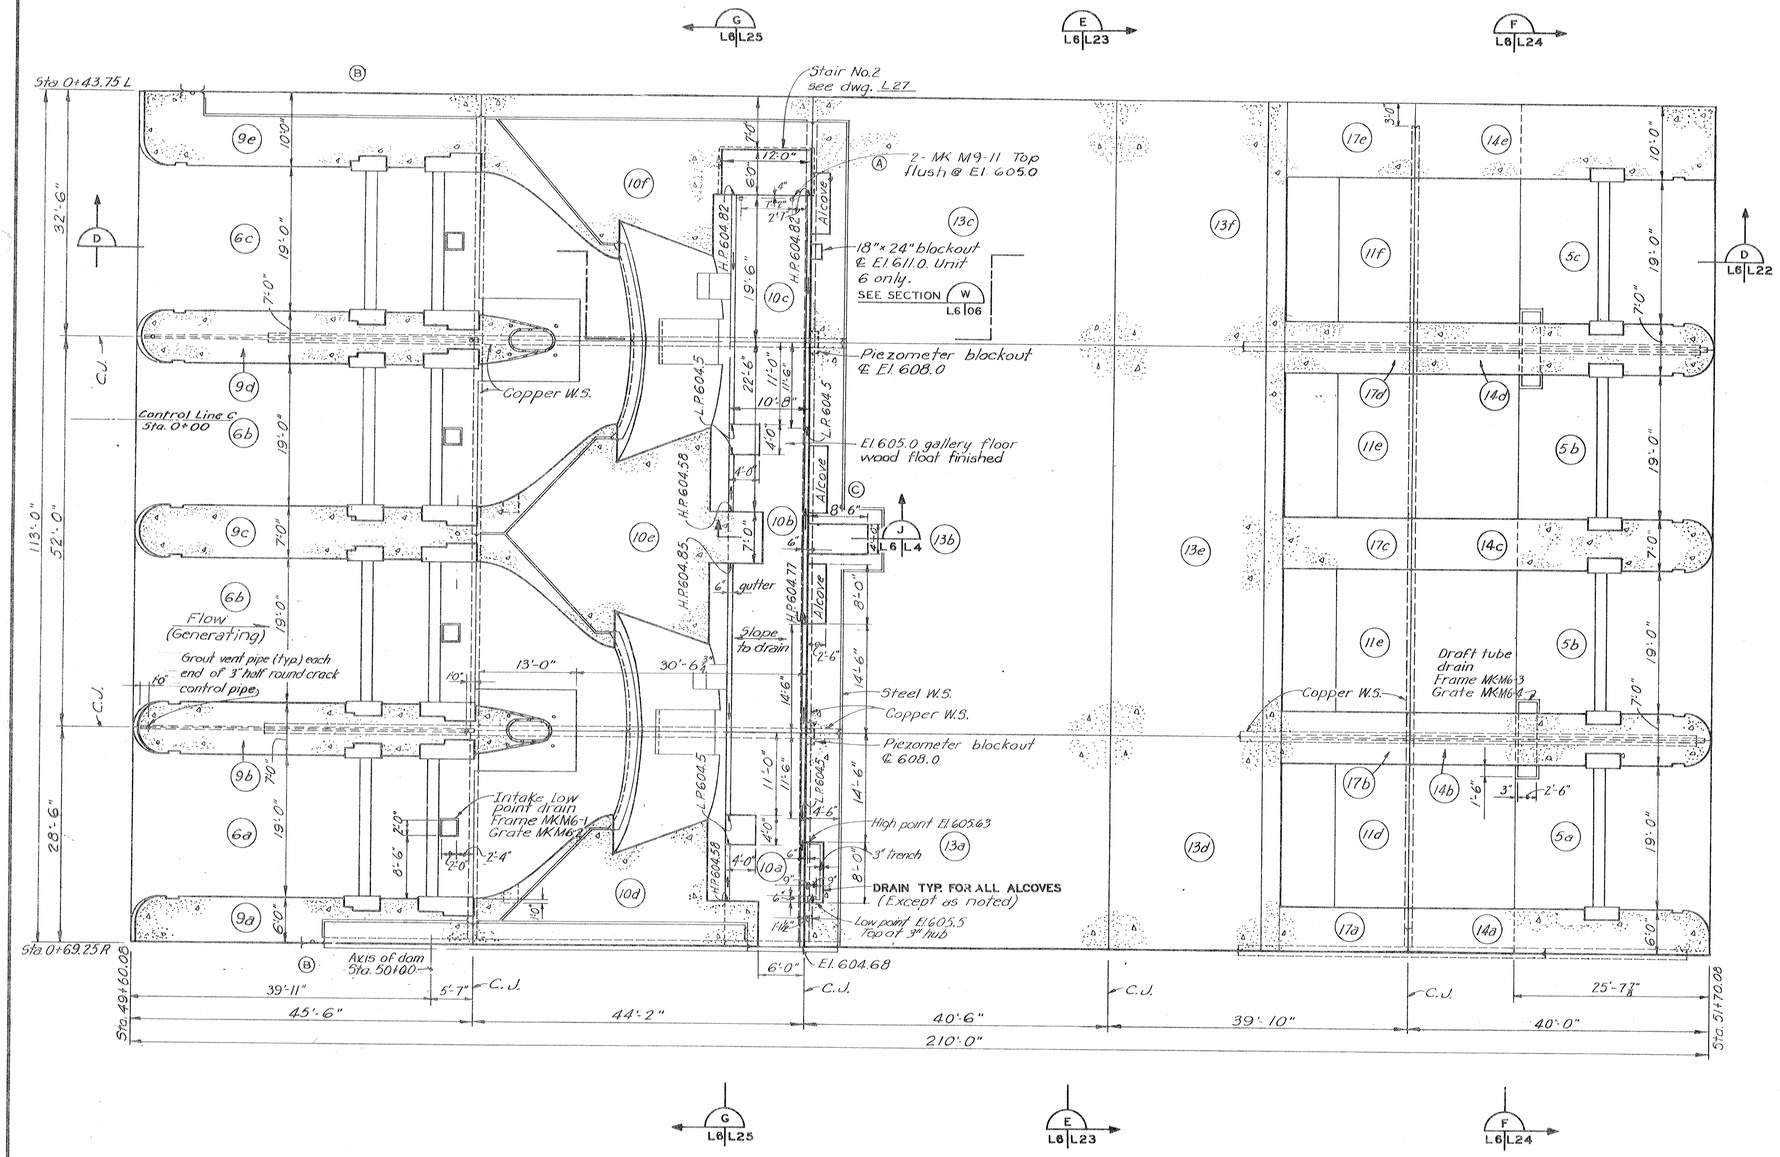

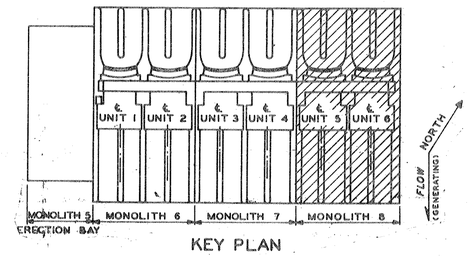

KEY PLAN

NOTES:

1. Work this drawing with L4, L5 and L22 thru L25.
2. See Note 2, dwg. L4.
3. Reinforcement dwgs. N2, N3, N6, N10, N11, N12

RECORD DRAWING

JANUARY 1974

CONTRACT NO. DACW41-71-C-0043

SYM.	DESCRIPTION	DATE	APP'D.
	Revised for "As Built" conditions	2/22/74	
C	CORRECT DIMENSION	9-27-71	
B	DELETE C.J. AND LIFT NUMBERS	9-29-71	
A	Add 2-MK M[illegible] plates	6-18-71	

REVISIONS

OSAGE RIVER

KAYSINGER BLUFF RESERVOIR

STAGE III CONSTRUCTION

POWERHOUSE SUBSTRUCTURE

GENERATOR MONOLITH

PLAN EL. 611.0 - UNITS 5 & 6

Dwg. No. L6

Scale: as shown

U. S. ARMY ENGINEER DISTRICT, KANSAS CITY, MO. AUG. 1970

PREPARED BY U. S. ARMY ENGINEER DISTRICT, OMAHA, NEBRASKA

Submitted: CHIEF DESIGN BRANCH USED OMAHA

Recommended: CHIEF, DESIGN BRANCH USED KANSAS CITY

Approved: CHIEF, ENGINEERING DIVISION USED KANSAS CITY

DESIGNED BY: G.D.H./O.F.S. DRAWN BY: R.C.R. CHECKED BY: J.O.C. FILE NO.

SCALE: 1/8 INCH=1 FOOT

12" 0 5' 10' 15'

SAFETY PAYS

0-12-2022

O. & M. M. PLATE NO. 332