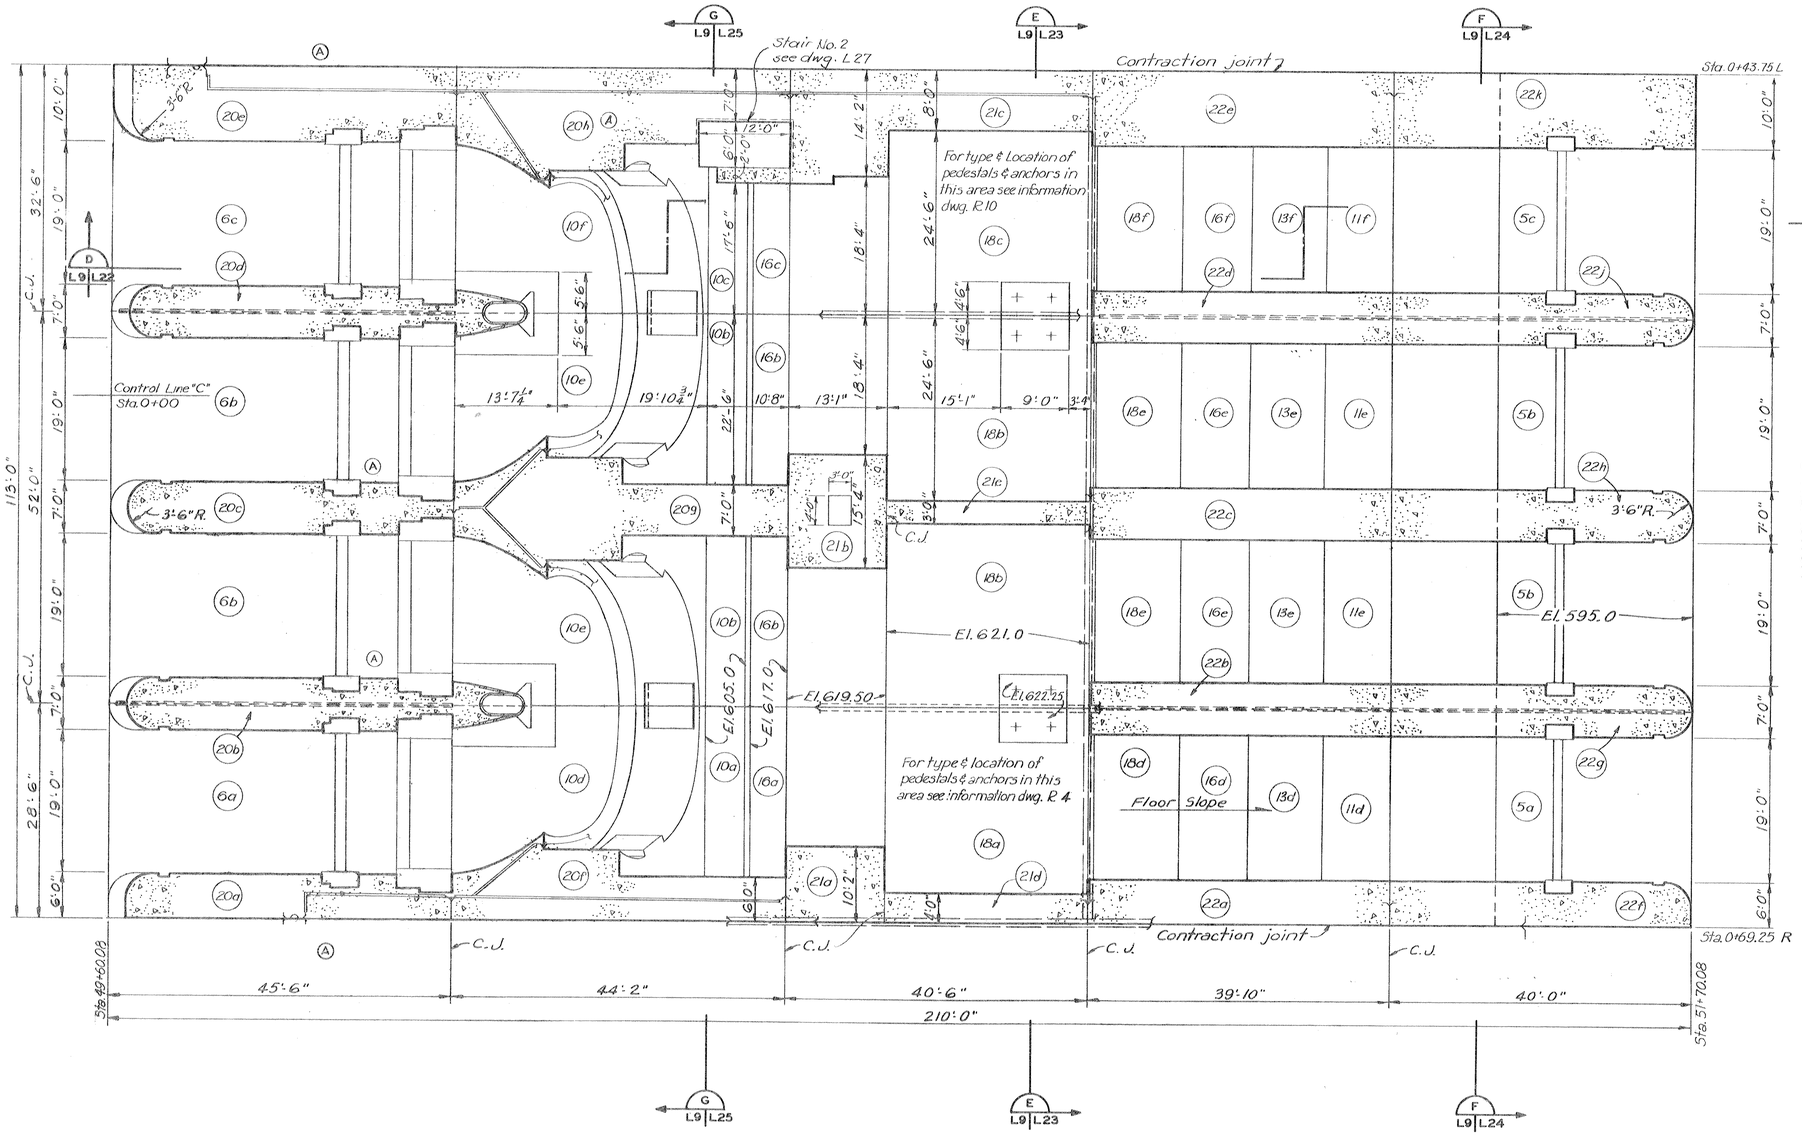

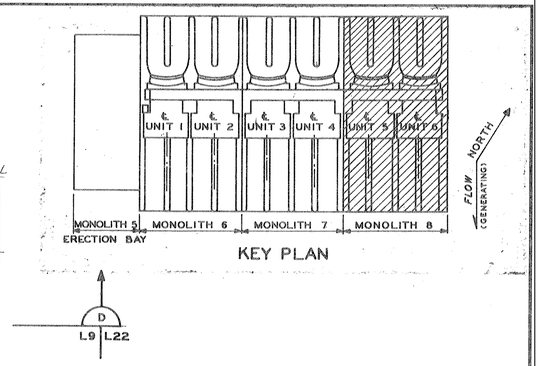

REFERENCE DWGS:

L7, L8, and L22 thru L25 - concrete.
N2, N3, N6, N10, N11, and N12 - reinforcement

RECORD DRAWING

JANUARY 1974

CONTRACT NO. DACW41-71-C-0043

SYM.	DESCRIPTION	DATE	APP'D.
	Revised for "As Built" conditions	8/12/74	
Ⓐ	DELETE C.J. AND REVISE LIFT NUMBERS	9-19-71	

REVISIONS

OSAGE RIVER

KAYSINGER BLUFF RESERVOIR

STAGE III CONSTRUCTION

POWERHOUSE SUBSTRUCTURE

GENERATOR MONOLITH

PLAN EL. 630.0 - UNITS 5 & 6

Dwg. No. L9 — Scale: as shown

U. S. ARMY ENGINEER DISTRICT, KANSAS CITY, MO. — AUG. 1970

PREPARED BY U. S. ARMY ENGINEER DISTRICT, OMAHA, NEBRASKA

Submitted: CHIEF, DESIGN BRANCH USED OMAHA — Recommended: CHIEF, DESIGN BRANCH USED KANSAS CITY — Approved: CHIEF, ENGINEERING DIVISION USED KANSAS CITY

DESIGNED BY: G.D.H./O.F.S. — DRAWN BY: R.C.R. — CHECKED BY: J. O. C. — FILE NO. 0-12-2025

O. & M. M. PLATE NO. 335