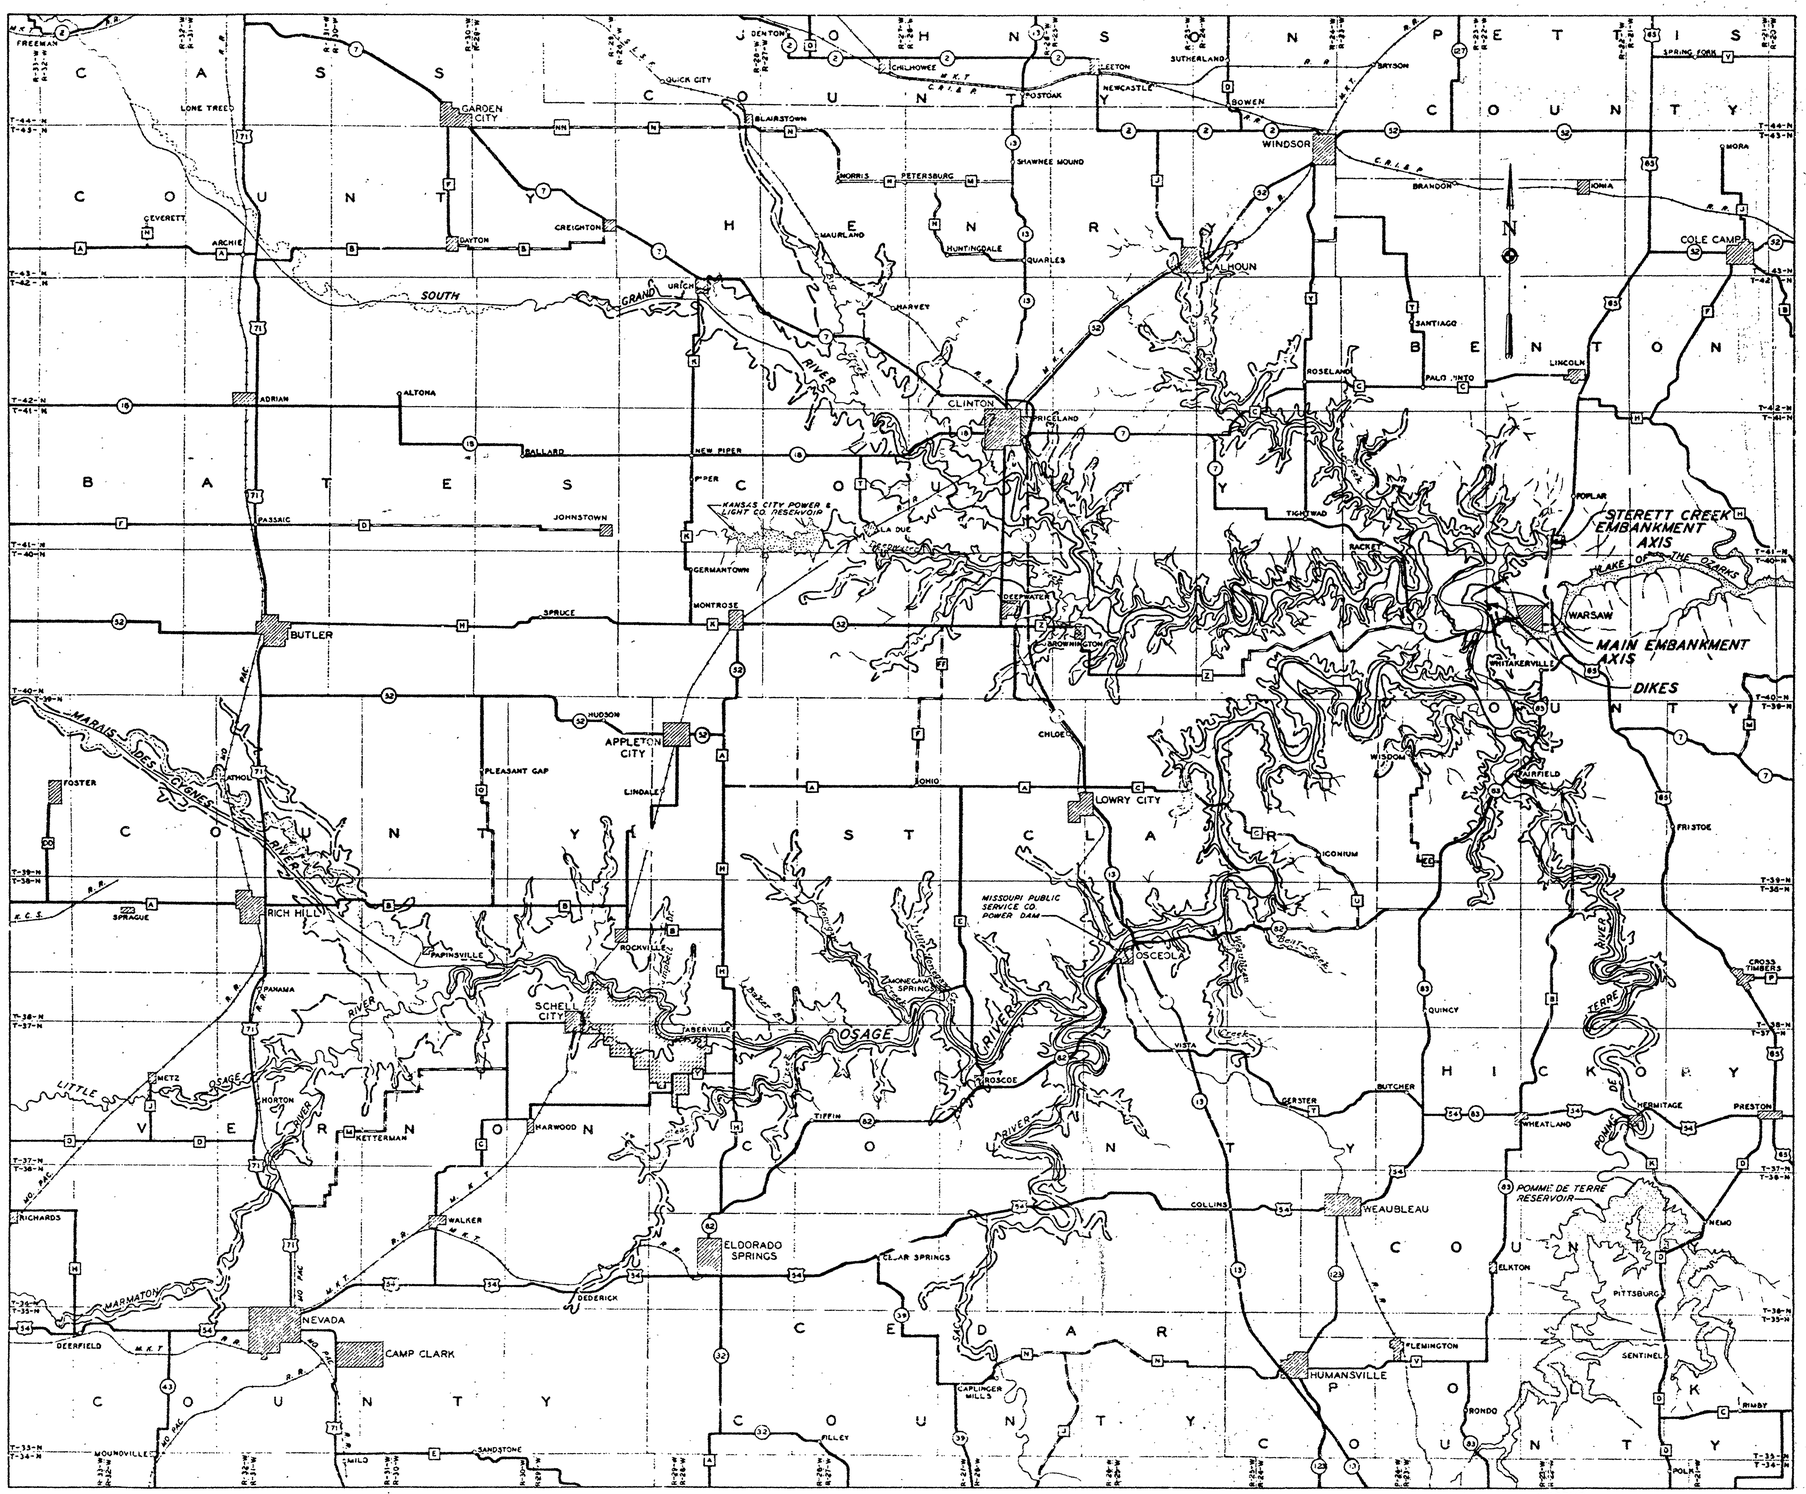

LOCATION

25 0 25 50 75 100

SCALE IN MILES

VICINITY

1 0 1 2 3 4 5 6

SCALE IN MILES

LEGEND

Full Pool 739.6

Multipurpose Pool & Top of Power Pool 706.0

Existing Reservoirs

Existing Schell - Osage Wildlife Management Area (State - Owned)

SOURCE OF RIPRAP AND BEDDING FOR THIS CONTRACT
GOVERNMENT QUARRY 3 N.E. QUARTER, SECTION 13, T-40-N, R-23-W, BENTON COUNTY, MO. BURLINGTON LIMESTONE

RECORD DRAWING

JANUARY 1974

CONTRACT NO. DACW41-71-C-0043

SYM.	DESCRIPTION	DATE	APP'D.
	Revised for "As Built" conditions	2/21/84	
	REVISIONS		

OSAGE RIVER BASIN

KAYSINGER BLUFF RESERVOIR

STAGE III CONSTRUCTION

LOCATION AND VICINITY

Dwg. No. A4

CORPS OF ENGINEERS
KANSAS CITY DISTRICT

Scale: as shown

U. S. ARMY
AUGUST 1970

Submitted: CHIEF, DAMS & FOUNDATIONS SECT.

Recommended: C.D. Gaddis, CHIEF, FOUNDATIONS & MATLS. BR.

Approved: CHIEF, ENGINEERING DIVISION

COMPILED BY: R.K.B. DRAWN BY: F.J.B. CHECKED BY: C.G.F.

FILE NO. O-12-1804

O. & M. M. PLATE NO. 146

MST00146.dgn 04/23/2004 10:00:13 AM