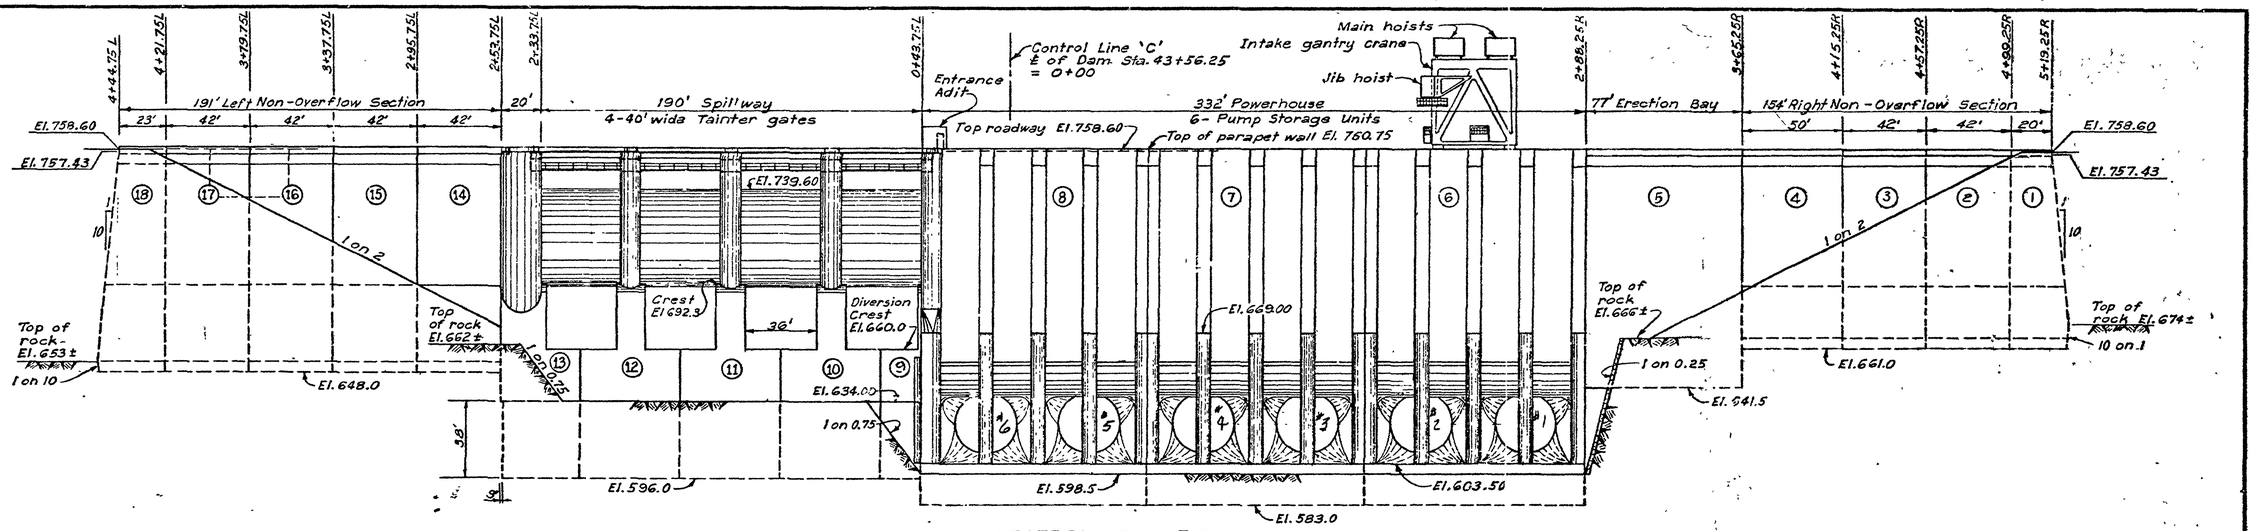

UPSTREAM ELEVATION
Scale: 1" = 30'

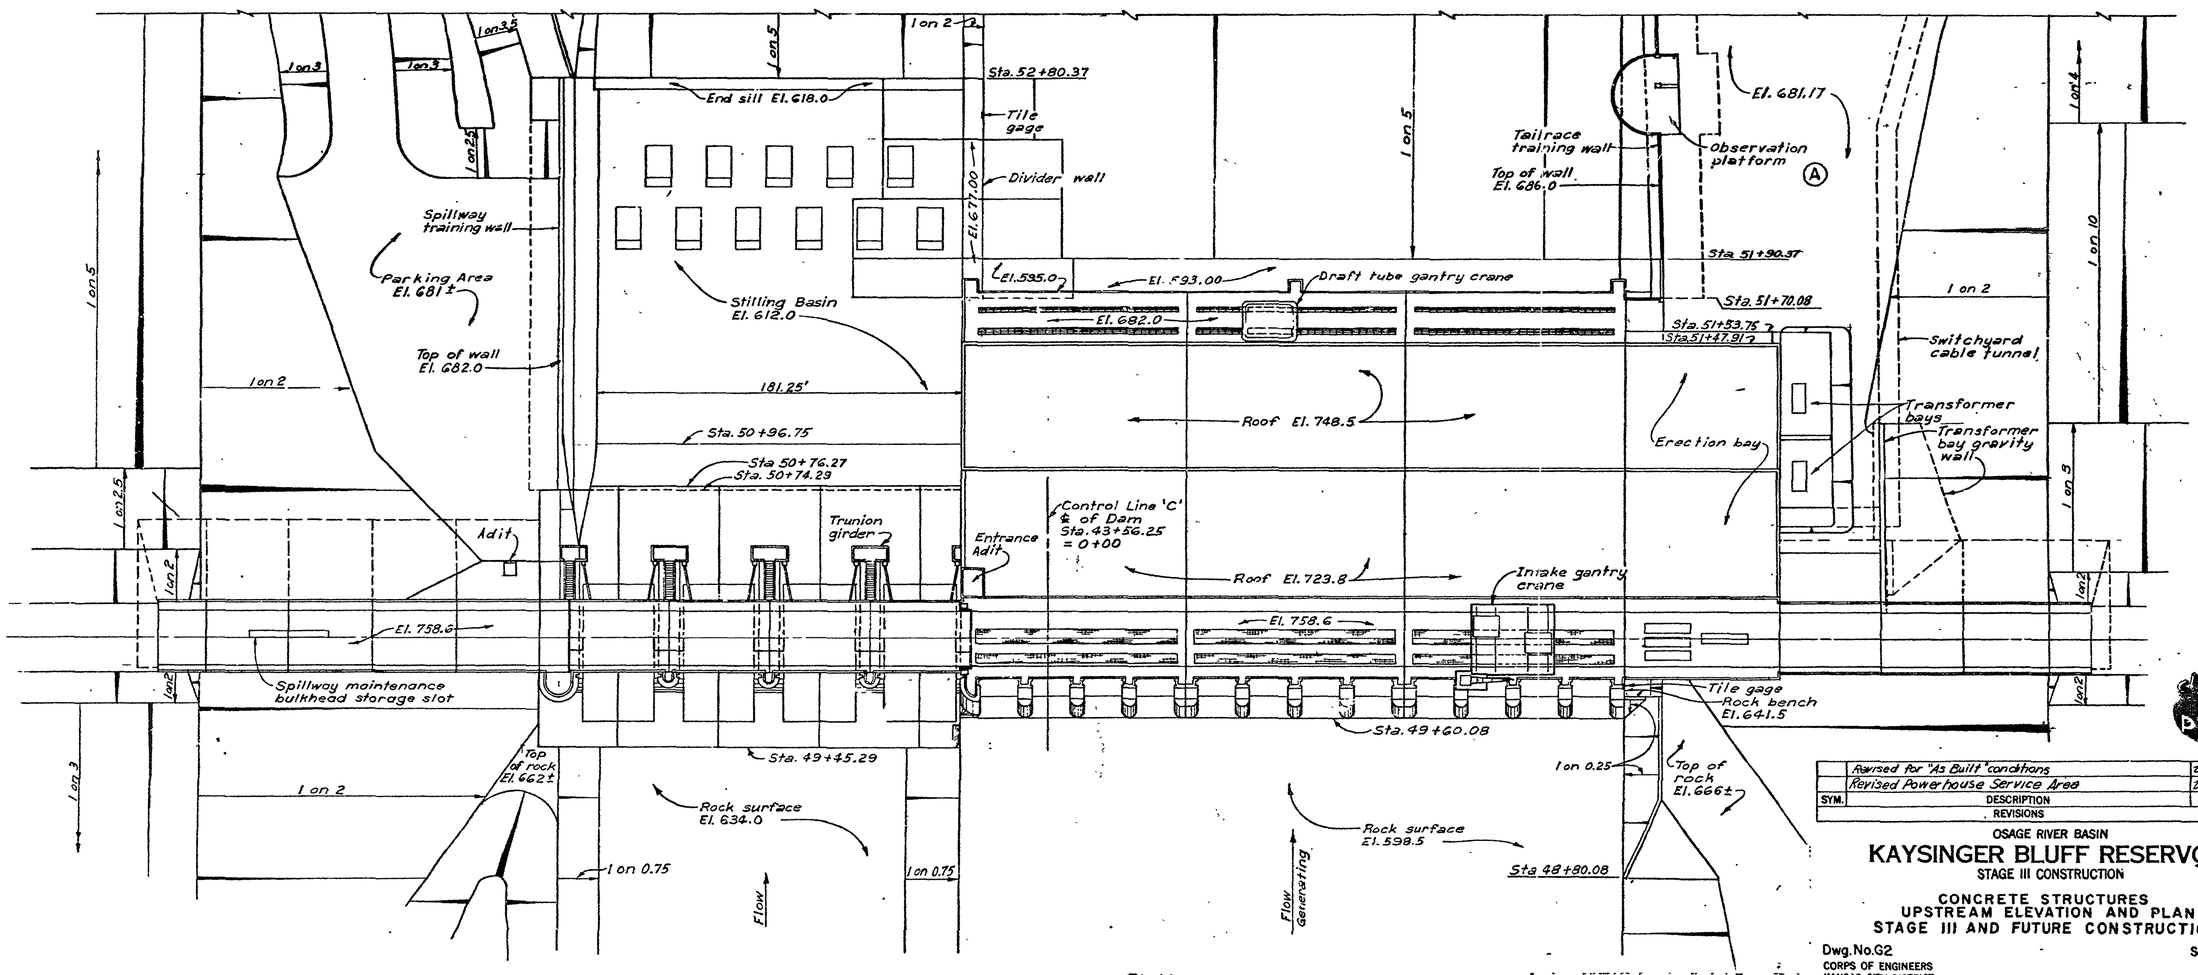

PLAN
Scale: 1" = 30'

SYM.	DESCRIPTION	DATE	APP'D.
	Revised for "As Built" conditions	2/22/74	GBR
	Revised Powerhouse Service Area	1/24/74	GBR

REVISIONS

OSAGE RIVER BASIN

KAYSINGER BLUFF RESERVOIR

STAGE III CONSTRUCTION

CONCRETE STRUCTURES
UPSTREAM ELEVATION AND PLAN
STAGE III AND FUTURE CONSTRUCTION

Dwg. No. G2
CORPS OF ENGINEERS
KANSAS CITY DISTRICT

Scale: 1" = 30'
U. S. ARMY
AUGUST 1970

Submitted: CHIEF, RESERVOIR STRUCTS. SECT.
Recommended: CHIEF, DESIGN BRANCH
Approved: CHIEF, ENGINEERING DIVISION

DESIGNED BY: M.D.J. DRAWN BY: J.A.R. CHECKED BY: M.D.J.

FILE NO. 0-12-1864

RECORD DRAWING
JANUARY 1974
CONTRACT NO. DACW41-71-C-0043

C. & M. M. PLATE NO. 192

HRT00192.dgn 04/23/2004 10:01:13 AM