


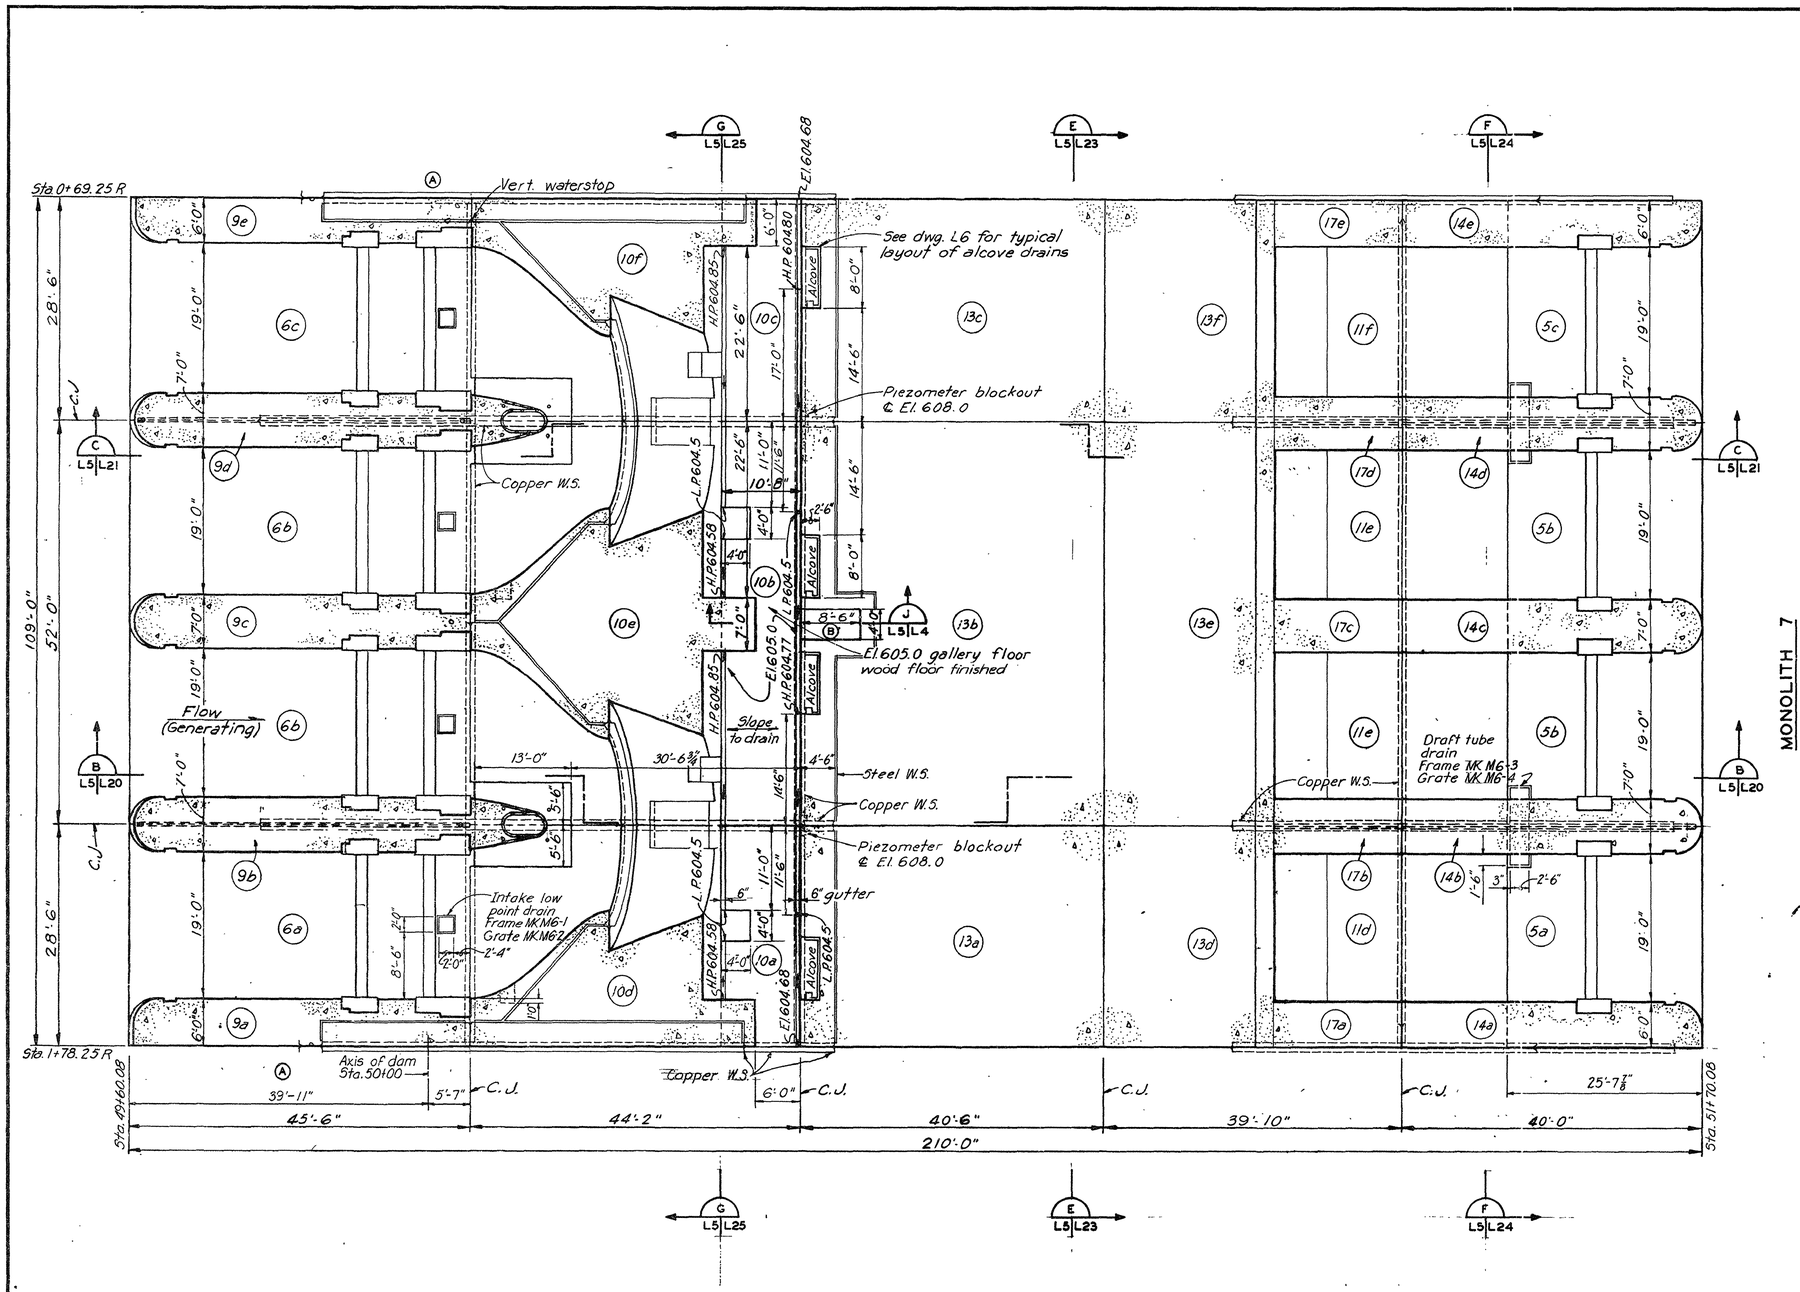


KEY PLAN

NOTES

1. Work this drawing with L4, L6, L20, L21, L23, L24 and L25.
2. See Note 2, dwg. L4.
3. Reinforcement dwgs. N2, N3, N6, N10, N11 and N12.

# RECORD DRAWING

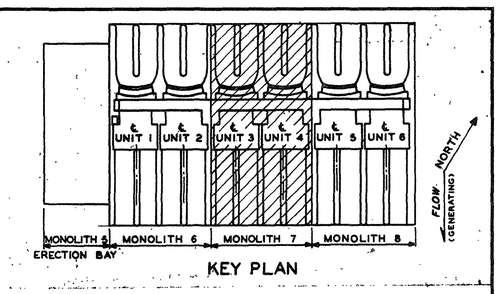JANUARY 1974

CONTRACT NO. DACW41-71-C-0043

| SYM. | DESCRIPTION | DATE | APP'D. |
|---|---|---|---|
| | Revised for "As Built" conditions | 7/12/84 | [illegible] |
| (B) | CORRECT DIMENSION | 9-29-71 | [illegible] |
| (A) | DELETE C.J. AND LIFT 9F, G, H, J, K. | 9-29-71 | [illegible] |

REVISIONS

OSAGE RIVER

## KAYSINGER BLUFF RESERVOIR

STAGE III CONSTRUCTION

POWERHOUSE SUBSTRUCTURE

GENERATOR MONOLITH

PLAN EL. 611.0 - UNITS 3 & 4

Dwg. No. L5 — Scale: as shown

U. S. ARMY ENGINEER DISTRICT, KANSAS CITY, MO. — AUG. 1970

PREPARED BY U. S. ARMY ENGINEER DISTRICT, OMAHA, NEBRASKA

Submitted: CHIEF, DESIGN BRANCH USED OMAHA — Recommended: CHIEF, DESIGN BRANCH USED KANSAS CITY — Approved: CHIEF, ENGINEERING DIVISION USED KANSAS CITY

DESIGNED BY: G.D.H./O.F.S. — DRAWN BY: R.C.R. — CHECKED BY: J.O.C. — FILE NO. 0-12-2021

SCALE: 1/8 INCH=1 FOOT

O. & M. M. PLATE NO. 331