CORPS OF ENGINEERS

U. S. ARMY

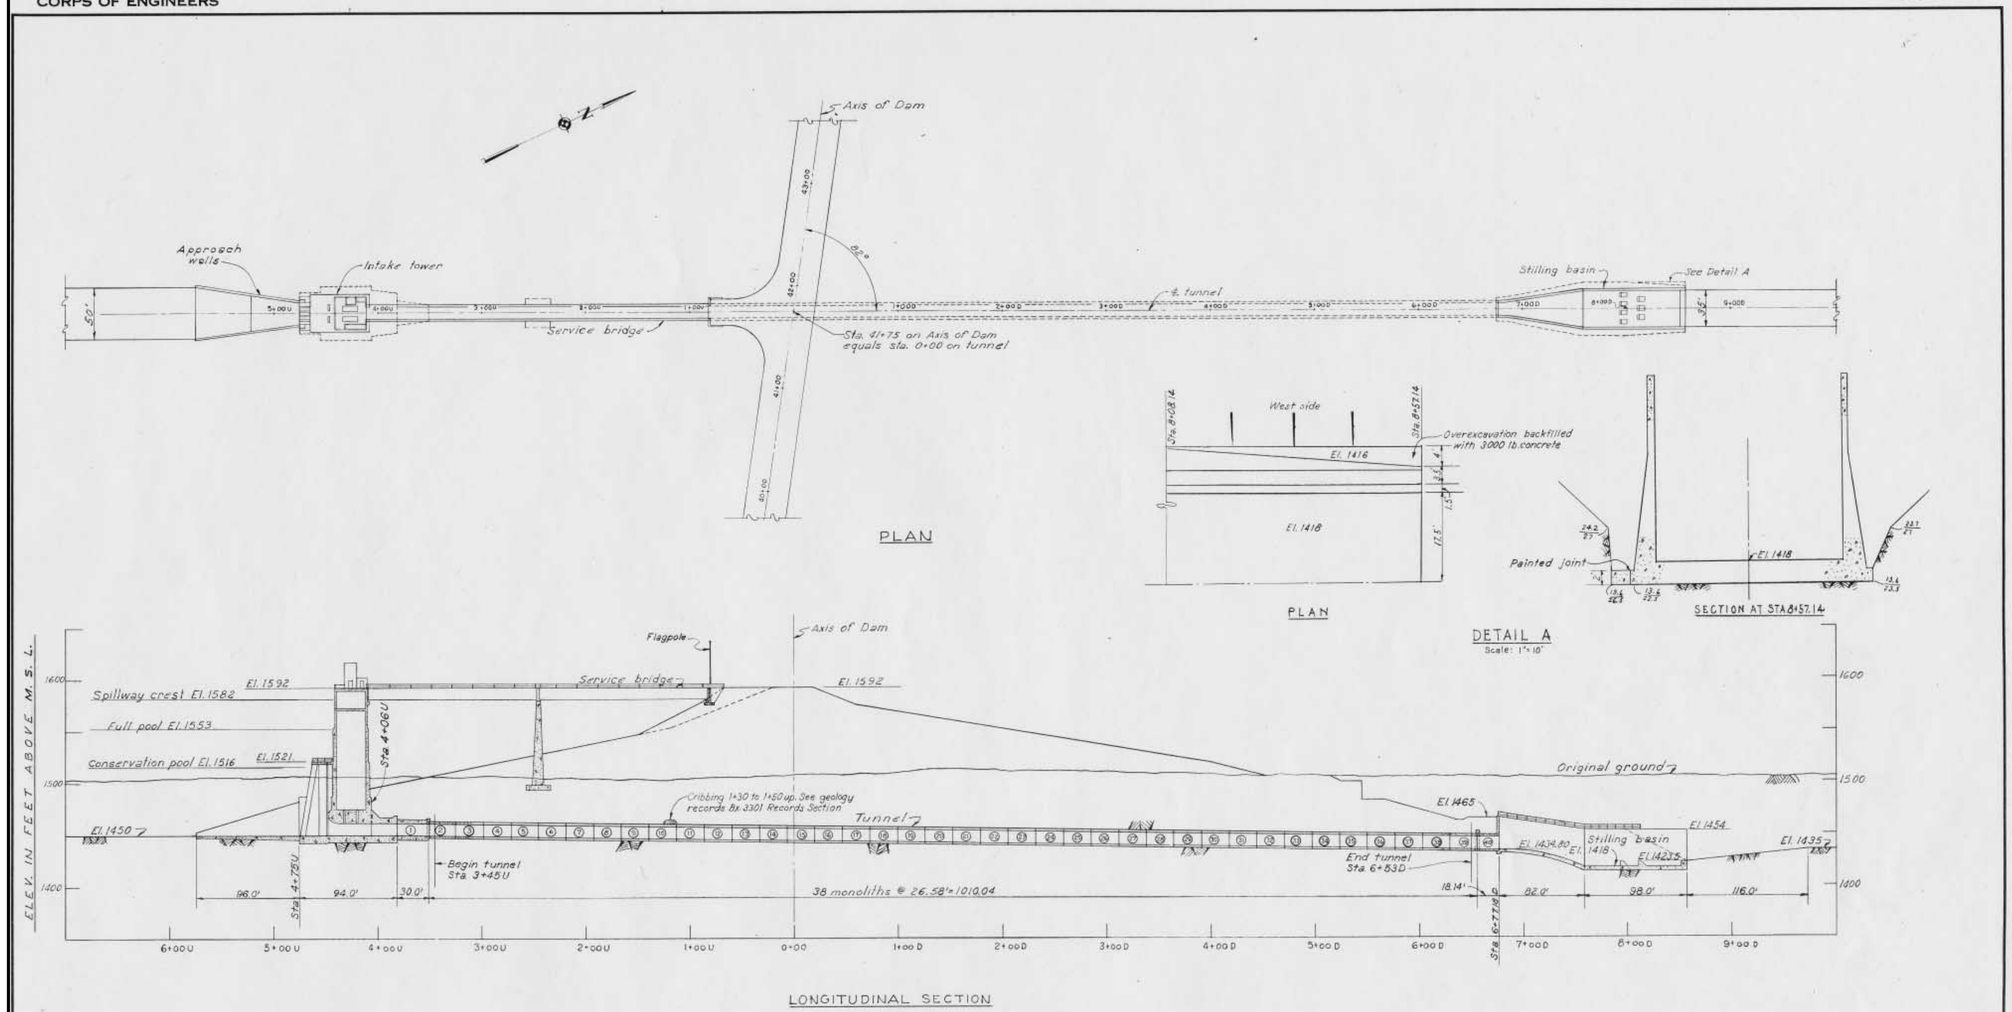

RECORD DRAWING

DECEMBER 1964

CONTRACT NO. DA-23-028-CIVENG-62-157

SYM.	DESCRIPTION	DATE	APP'D
(A)	Revised for "As Built" conditions	1-17-67	

REVISIONS

KANSAS RIVER BASIN

WILSON DAM

SALINE RIVER, KANSAS

OUTLET WORKS
PLAN AND LONGITUDINAL SECTION

In 108 sheets — Sheet No. 14 — Scale: 1" = 50'-0"

U. S. ARMY ENGINEER DISTRICT
KANSAS CITY

KANSAS CITY, MO.
AUGUST 1961

Submitted: Earl B. Cohn, CHIEF, STRUCTURAL SECTION — DRAWN BY: H.G.I. — TRACED BY:

Recommended: R. P. Gillen, CHIEF, DESIGN BRANCH — CHECKED BY: M.M.H.

Approved: Louis A. Feld, CHIEF, ENGINEERING DIVISION

FILE NO. E-1-454

SAFETY PAYS

O. & M. M. PLATE NO. 15

FOR INFORMATION ONLY

US Army Corps of Engineers
Kansas City District

Symbol	Description	Date	Appr.

Designed by: H.T.Y.
Date: APRIL 2004
Rev.
Dwn by: H.T.Y.
Ckd by: R.S.K.
Design file no. E-1-1682
Reviewed by:
Drawing code:
Submitted by: D.L.M.
File name: WIW003.DGN
Plot date:
Plot scale: 0.833333:1

U.S. ARMY ENGINEER DISTRICT
CORPS OF ENGINEERS
KANSAS CITY, MISSOURI

SALINE RIVER, KANSAS
WILSON LAKE
STILLING BASIN WALL REPAIR

OUTLET WORKS PLAN AND LONGITUDINAL SECTION

Sheet reference number:
1-3