CORPS OF ENGINEERS

U. S. ARMY

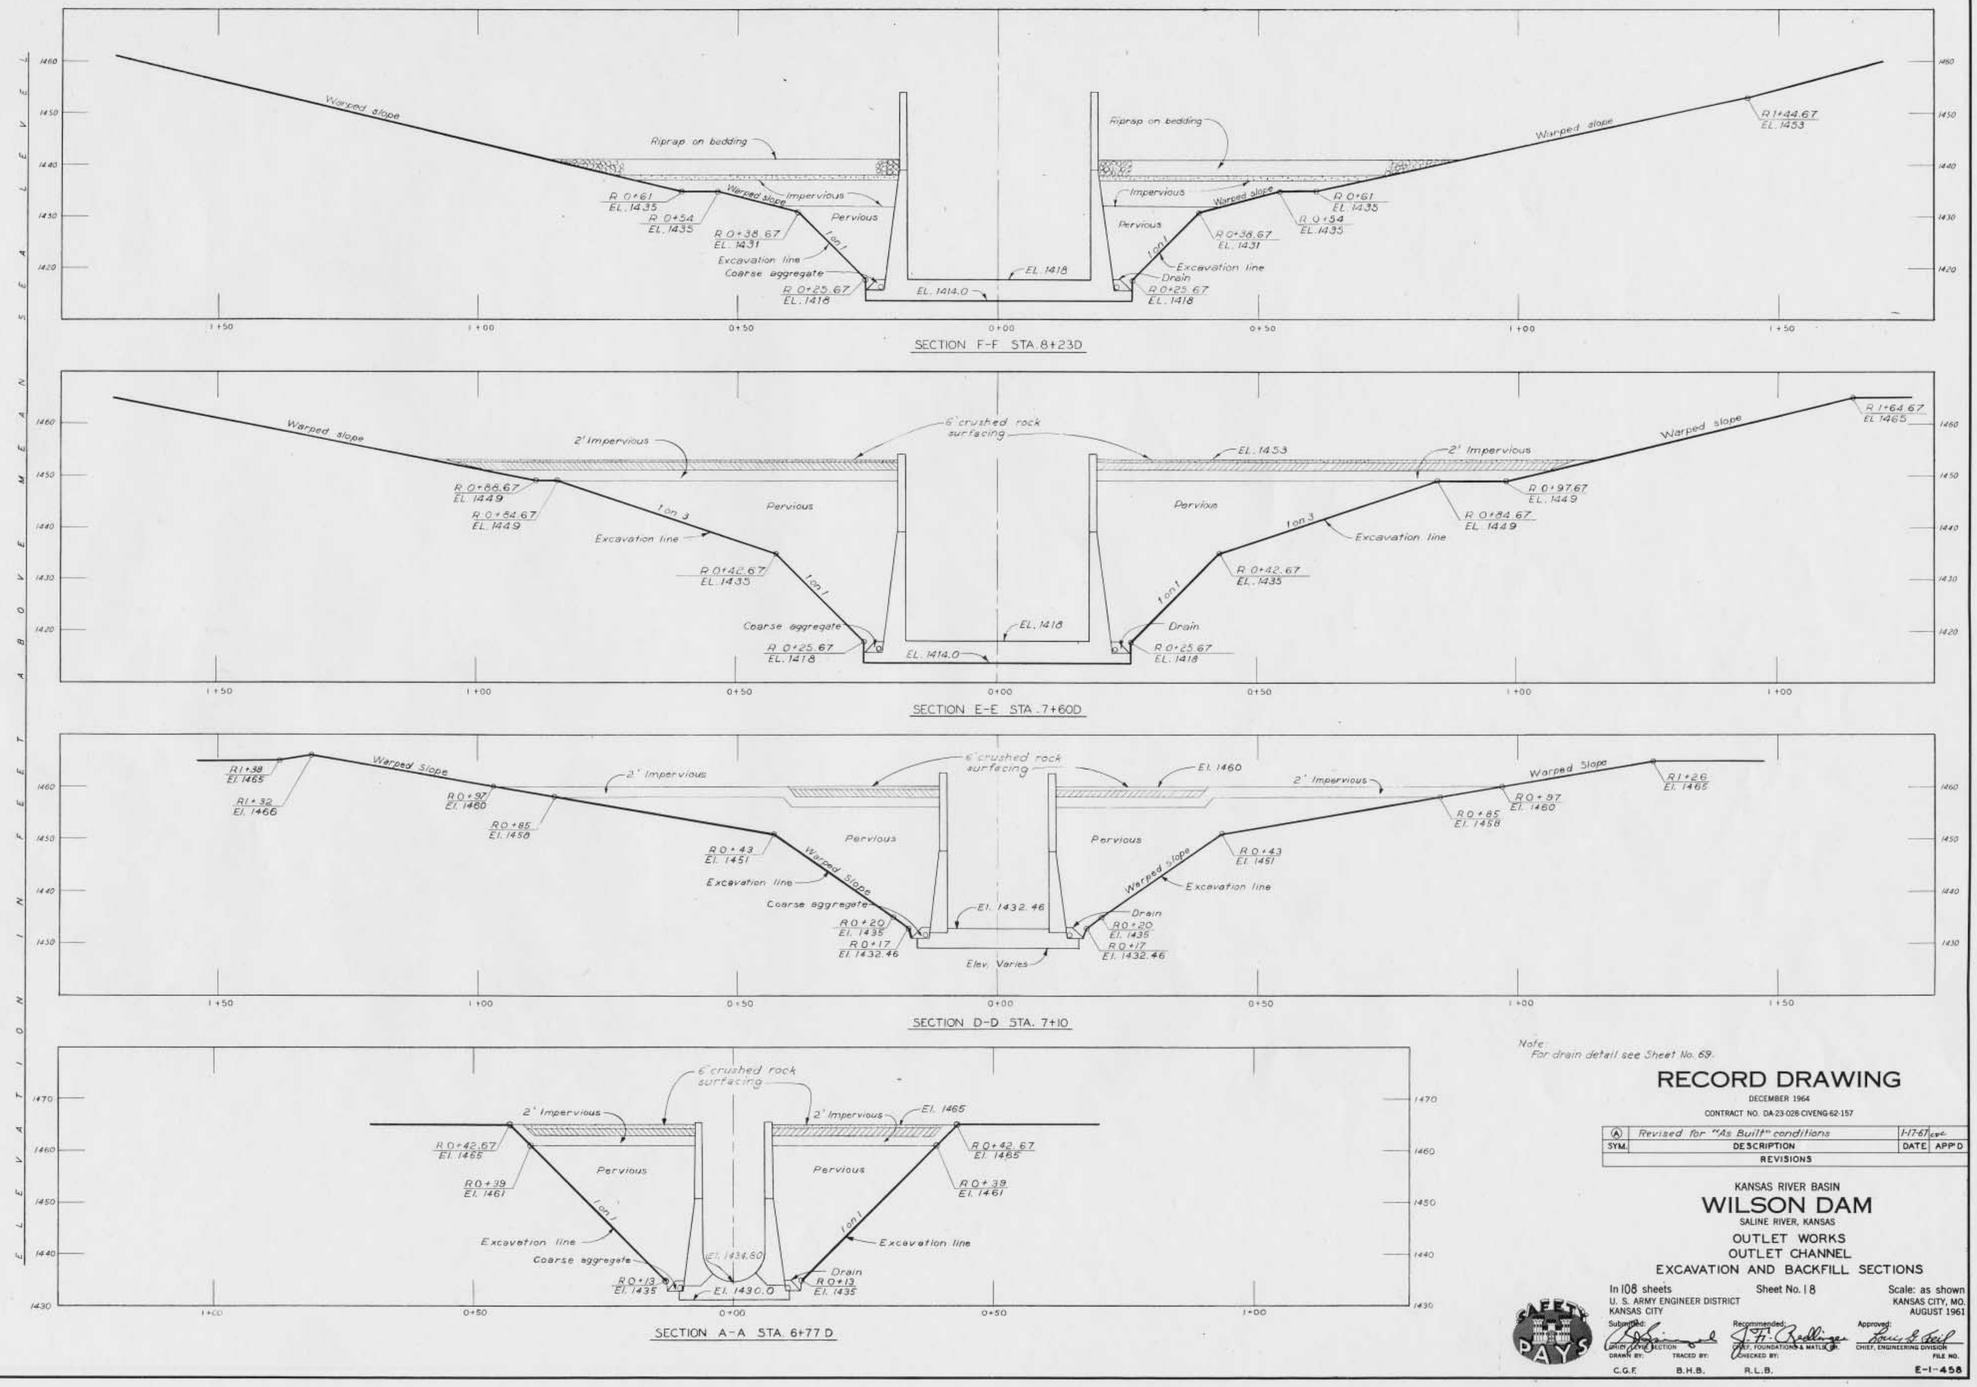

Note:
For drain detail see Sheet No. 69.

RECORD DRAWING

DECEMBER 1964

CONTRACT NO. DA-23-028-CIVENG-62-157

SYM.	DESCRIPTION	DATE	APP'D
A	Revised for "As Built" conditions	1-17-67	cvc

REVISIONS

KANSAS RIVER BASIN

WILSON DAM

SALINE RIVER, KANSAS

OUTLET WORKS
OUTLET CHANNEL
EXCAVATION AND BACKFILL SECTIONS

In 108 sheets — Sheet No. 18 — Scale: as shown

U. S. ARMY ENGINEER DISTRICT
KANSAS CITY

KANSAS CITY, MO.
AUGUST 1961

Submitted: CHIEF, LEVEE SECTION — DRAWN BY: C.G.F. — TRACED BY: B.H.B.

Recommended: CHIEF, FOUNDATIONS & MATLS. BR. — CHECKED BY: R.L.B.

Approved: CHIEF, ENGINEERING DIVISION — FILE NO. E-1-458

O. & M. M. PLATE NO. 19

FOR INFORMATION ONLY

US Army Corps of Engineers
Kansas City District

Symbol	Description	Date	Appr.

Designed by: H.T.Y.
Dwn by: H.T.Y.
Ckd by: R.S.K.
Reviewed by:
Submitted by: D.L.M.
Date: APRIL 2004
Design file no. E-1-1684
Drawing code:
File name: WIW1005.DGN
Plot date:
Plot scale: .083333:1
Rev.

U.S. ARMY ENGINEER DISTRICT
CORPS OF ENGINEERS
KANSAS CITY, MISSOURI

SALINE RIVER, KANSAS
WILSON LAKE
STILLING BASIN WALL REPAIR

OUTLET WORKS OUTLET CHANNEL EXCAVATION AND BACKFILL SECTIONS

Sheet reference number:
I-5