CORPS OF ENGINEERS

U. S. ARMY

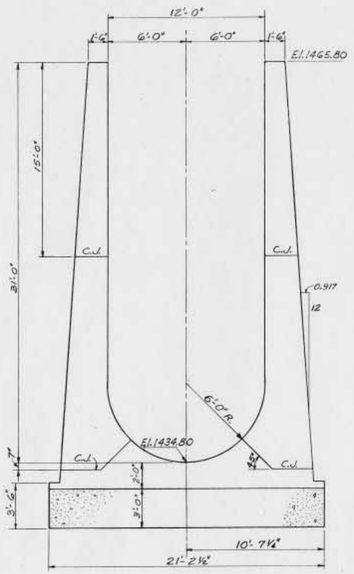

Ⓐ SECTION A-A

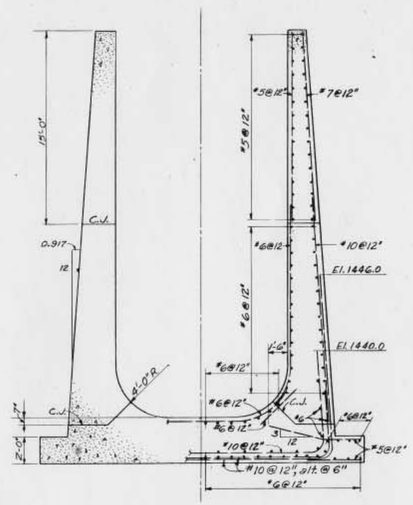

REINF. TYPICAL FOR MONOLITH 1

SECTION B-B

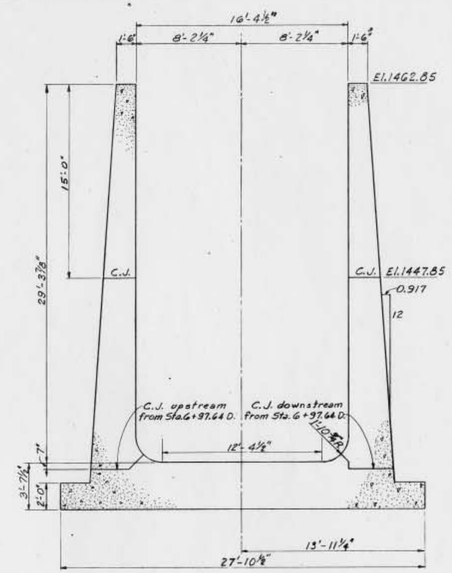

Ⓐ SECTION C-C

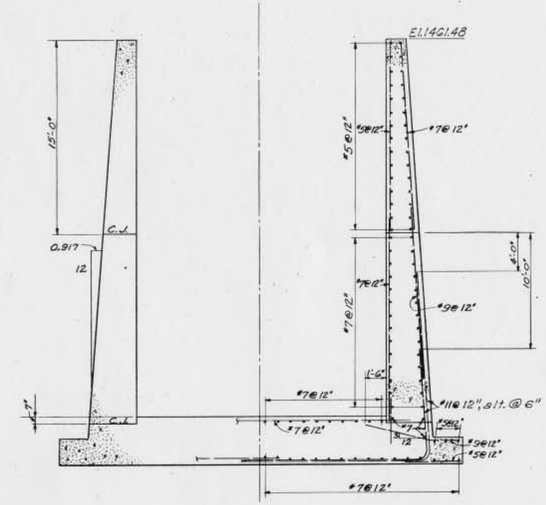

REINF. TYPICAL FOR MONOLITHS 2 & 3

Ⓐ SECTION D-D

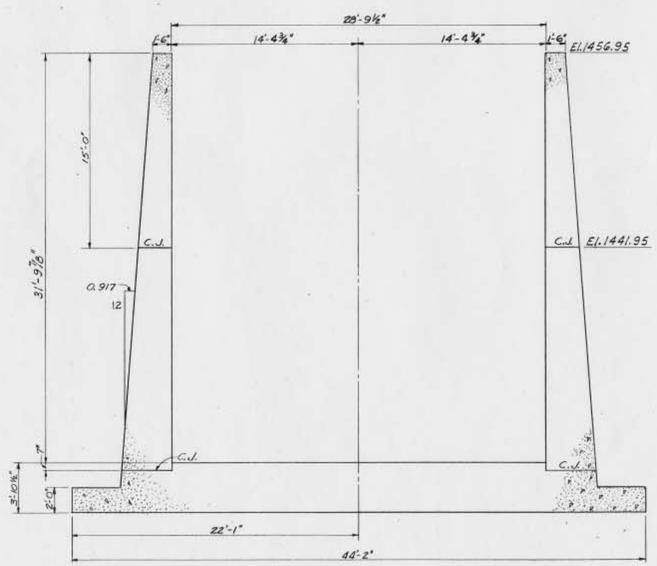

Ⓐ SECTION E-E

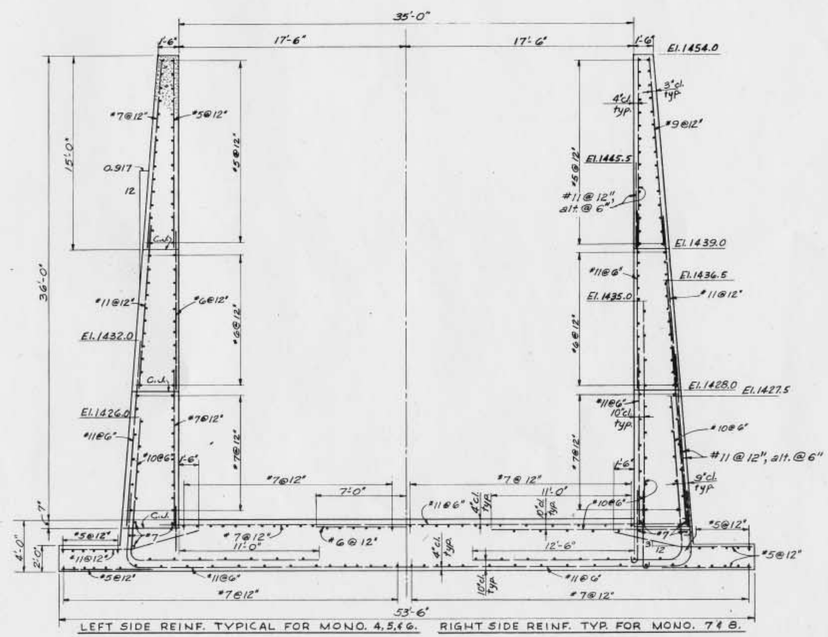

LEFT SIDE REINF. TYPICAL FOR MONO. 4, 5, & 6. RIGHT SIDE REINF. TYP. FOR MONO. 7 & 8.

SECTION F-F

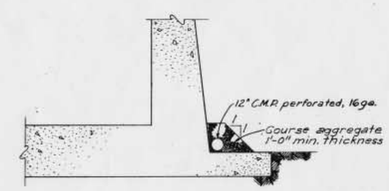

WALL DRAIN DETAIL

NOTES:
Clear distance of reinforcement from surface of concrete shall be as shown on Section F-F.
For other notes see Sheet No. 68.
All Sections sym. about ℄.

RECORD DRAWING

DECEMBER 1964

CONTRACT NO. DA-23-028-CIVENG-62-157

SYM.	DESCRIPTION	DATE	APP'D.
Ⓑ	Revised for "As-Built" conditions	1-17-67	R.K.
Ⓐ	Elevation and dimension changes.	4-11-63	R.K.

REVISIONS

KANSAS RIVER BASIN

WILSON DAM

SALINE RIVER, KANSAS

OUTLET WORKS
STILLING BASIN
WALL SECTIONS
STRUCTURAL

In 108 sheets — Sheet No. 69 — Scale: ¼"=1'-0"

U. S. ARMY ENGINEER DISTRICT
KANSAS CITY

KANSAS CITY, MO.
AUGUST 1961

Submitted: Earl B. Cohn, CHIEF, STRUCTURAL SECTION — Recommended: R. T. Gillis, CHIEF, DESIGN BRANCH — Approved: Louis A. Feiler, CHIEF, ENGINEERING DIVISION

DRAWN BY: K.E.F. TRACED BY: CHECKED BY: M.M.H. FILE NO. E-1-509

O. & M. M. PLATE NO. 74

FOR INFORMATION ONLY

US Army Corps of Engineers
Kansas City District

Symbol	Description	Date	Appr.

Designed by: H.T.Y.
Date: APRIL 2004
Rev.
Dwn by: H.T.Y.
Ctd by: R.S.K.
Design file no. E-1-1687
Reviewed by:
Drawing code:
Submitted by: D.L.M.
File name: WIW1008.DGN
Plot date:
Plot scale: 0.833333:1

U.S. ARMY ENGINEER DISTRICT
CORPS OF ENGINEERS
KANSAS CITY, MISSOURI

SALINE RIVER, KANSAS
WILSON LAKE
STILLING BASIN WALL REPAIR

OUTLET WORKS STILLING BASIN
WALL SECTIONS STRUCTURAL

Sheet reference number:
1-8