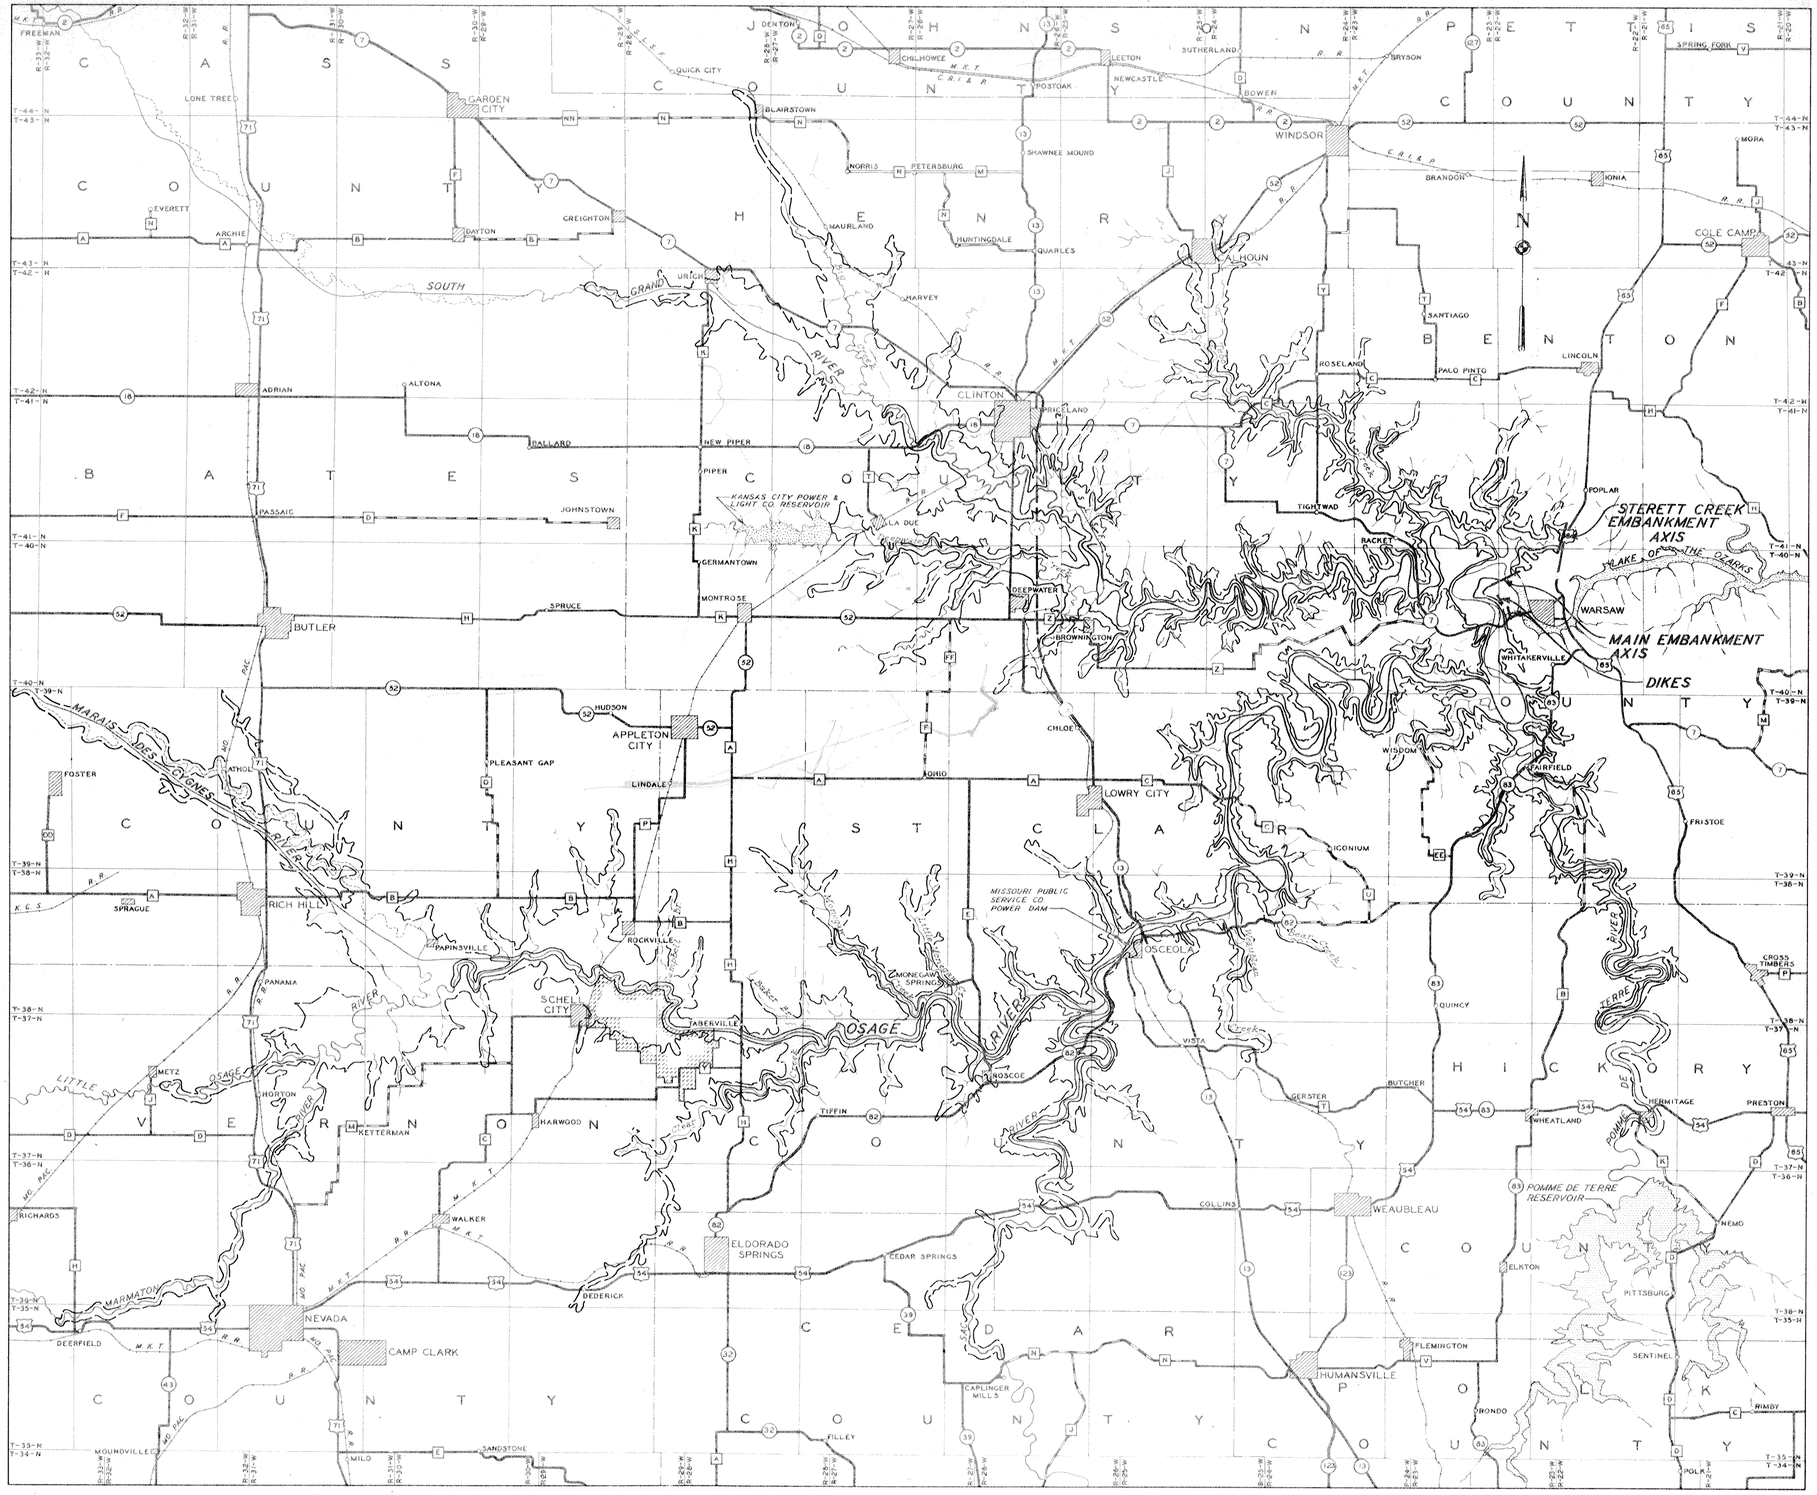

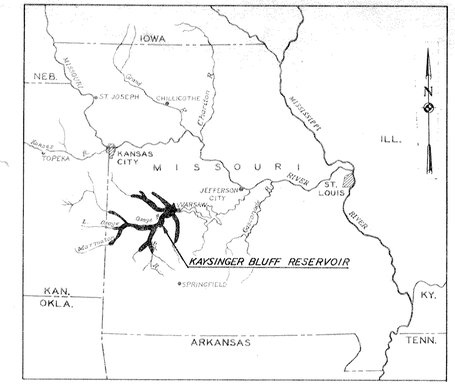

LOCATION

25 0 25 50 75 100

SCALE IN MILES

SOURCE OF RIPRAP AND BEDDING FOR THIS CONTRACT

GOVERNMENT QUARRY 3
N.E. QUARTER, SECTION 13, T-40-N, R-23-W,
BENTON COUNTY, MO.
BURLINGTON LIMESTONE

VICINITY

1 0 1 2 3 4 5 6

SCALE IN MILES

LEGEND

Full Pool — 739.6
Multipurpose Pool & Top of Power Pool — 706.0
Existing Reservoirs
Existing Schell - Osage Wildlife Management Area (State - Owned)

RECORD DRAWING

JANUARY 1974

CONTRACT NO. DACW41-71-C-0043

SYM.	DESCRIPTION	DATE	APP'D.
	Revised for "As Built" conditions	2/22/84	[illegible]

REVISIONS

OSAGE RIVER BASIN

KAYSINGER BLUFF RESERVOIR

STAGE III CONSTRUCTION

LOCATION AND VICINITY

Dwg. No. A4

CORPS OF ENGINEERS
KANSAS CITY DISTRICT

Scale: as shown
U. S. ARMY
AUGUST 1970

Submitted: [signature] CHIEF, DAMS & FOUNDATIONS SECT.
Recommended: C.D. Craddock CHIEF, FOUNDATIONS & MATLS. BR.
Approved: [signature] CHIEF, ENGINEERING DIVISION

COMPILED BY: R.K.B. DRAWN BY: F.J.B. CHECKED BY: C.G.F.

FILE NO. O-12-1804

O. & M. M. PLATE NO. 146