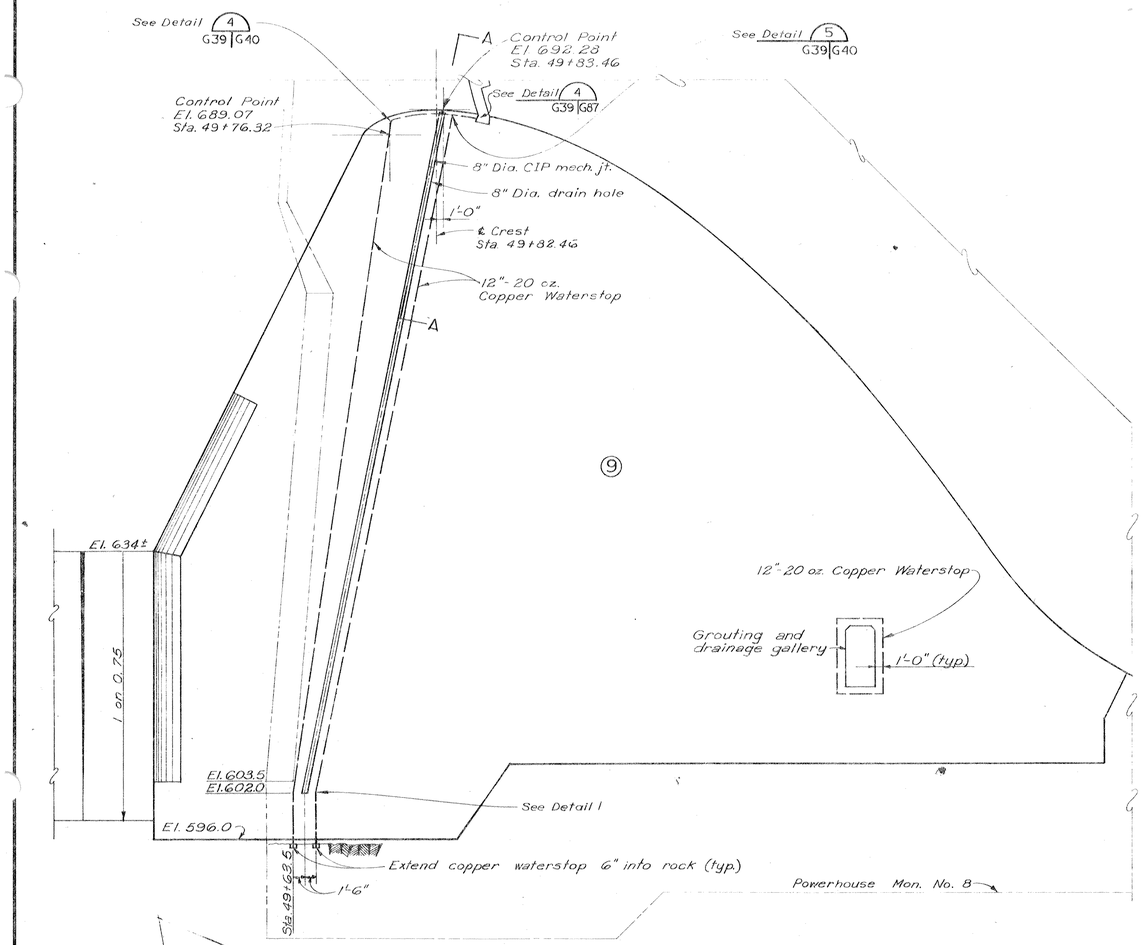

M. J. BETWEEN MON NO'S. 8 & 9
Scale: 1/8" = 1'-0

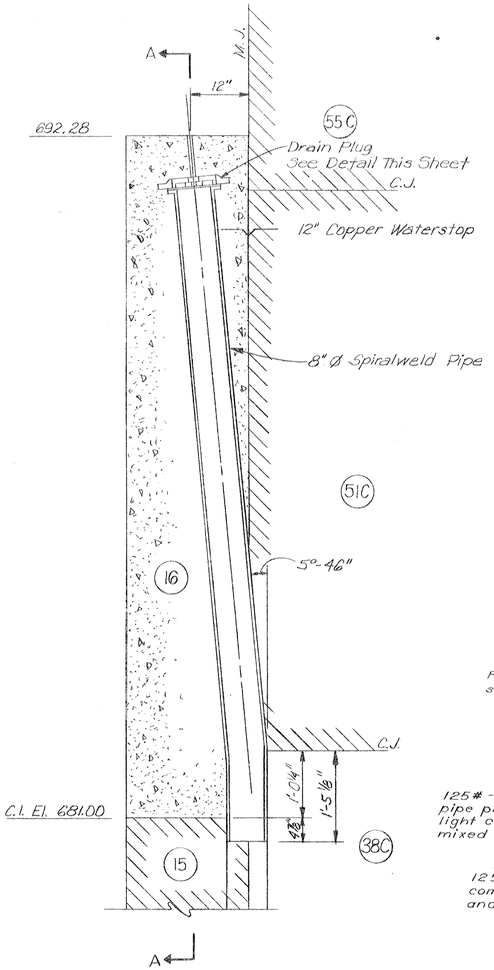

SECTION A

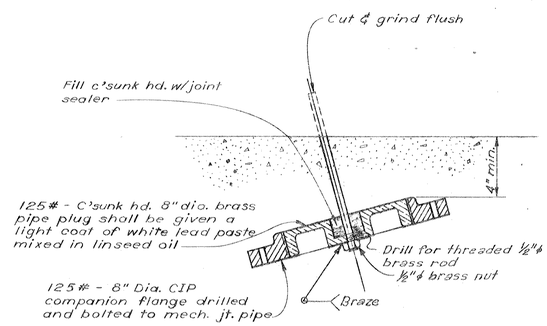

DRAIN PLUG DETAIL
Scale: 3" = 1'-0"

NOTES:
CIP - Cast Iron Pipe
Mech. jt. - Mechanical joint

REFERENCE DWGS.

Spillway - Upstream Elev.	G18
Waterstop Details	G38 & G40
Galleries	G41
Bottom Seal Plate Details	G86 & G87

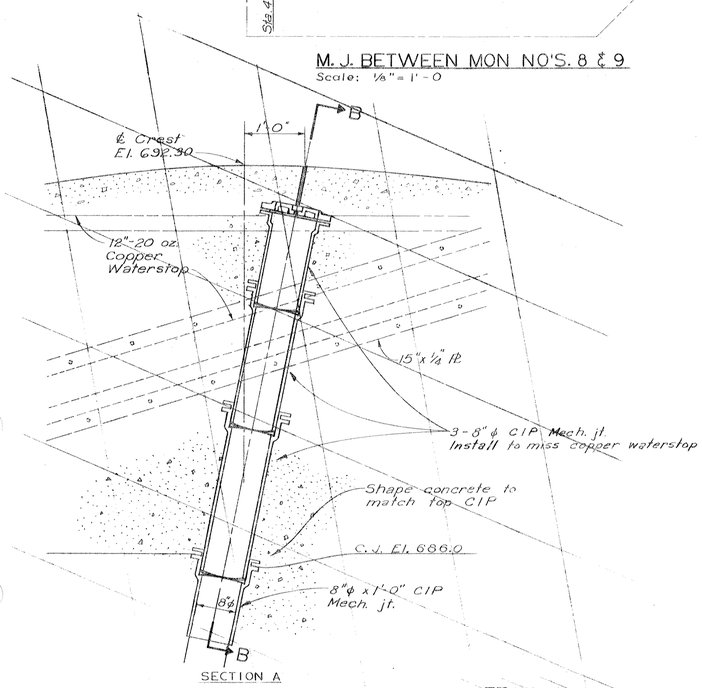

SECTION A

DETAIL 1
Scale: 1" = 1'-0"

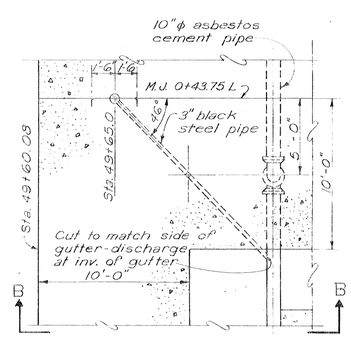

PLAN

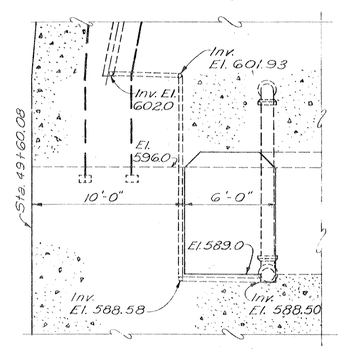

SECTION B

DETAIL 1
Scale: 1/4" = 1'-0"

RECORD DRAWING

JANUARY 1974

CONTRACT NO. DACW41-71-C-0043

SYM.	DESCRIPTION	DATE	APP'D.
	Revised for "As Built" conditions	2/22/94	[illegible]

REVISIONS

OSAGE RIVER BASIN

KAYSINGER BLUFF RESERVOIR

STAGE III CONSTRUCTION

WATERSTOPS AND DRAIN DETAILS
NON-OVERFLOW AND SPILLWAY

Dwg. No. G39
CORPS OF ENGINEERS
KANSAS CITY DISTRICT

Scale: as shown
U. S. ARMY
AUGUST 1970

Submitted: [signature] CHIEF, RESERVOIR STRUCTS. SECT.
Recommended: [signature] CHIEF, DESIGN BRANCH
Approved: [signature] CHIEF, ENGINEERING DIVISION

DESIGNED BY: M.D.J. DRAWN BY: L.W.S. CHECKED BY: M.D.J. FILE NO. 0-12-1901

SAFETY PAYS

O. & M. M. PLATE NO. 227