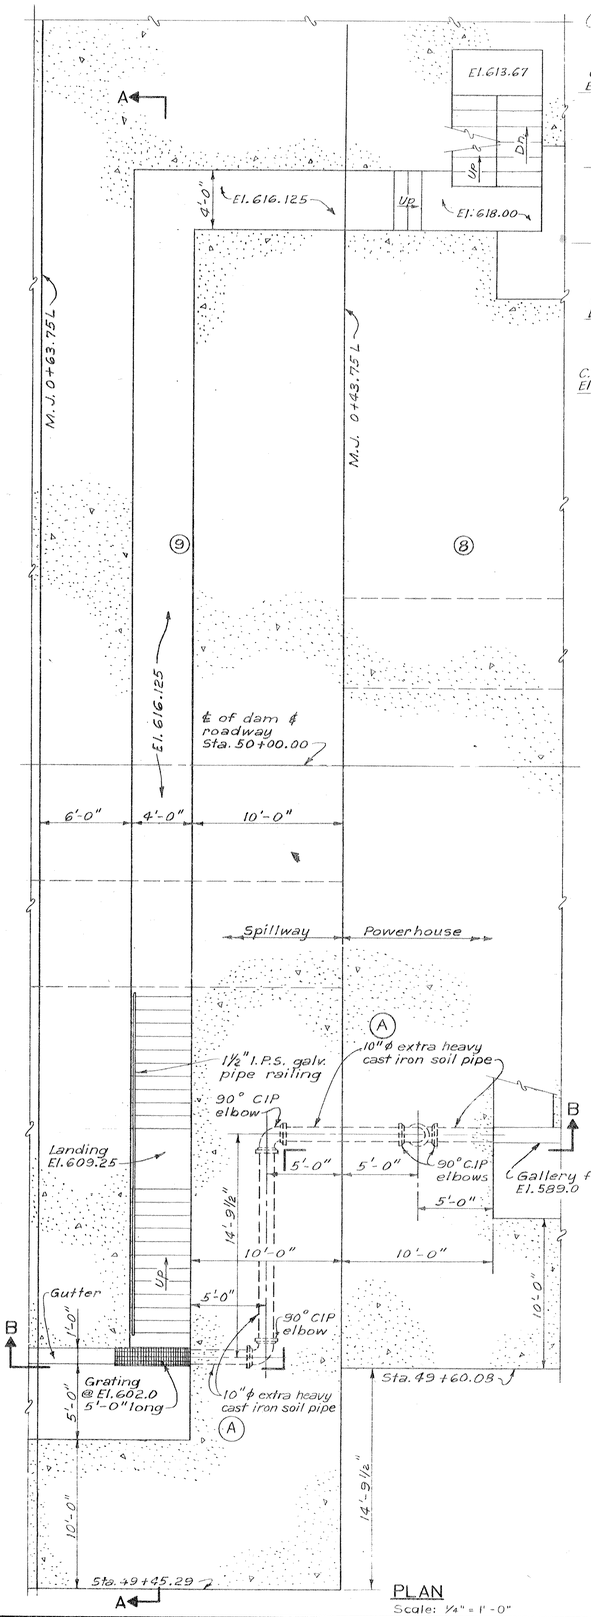

PLAN
Scale: ¼" = 1'-0"

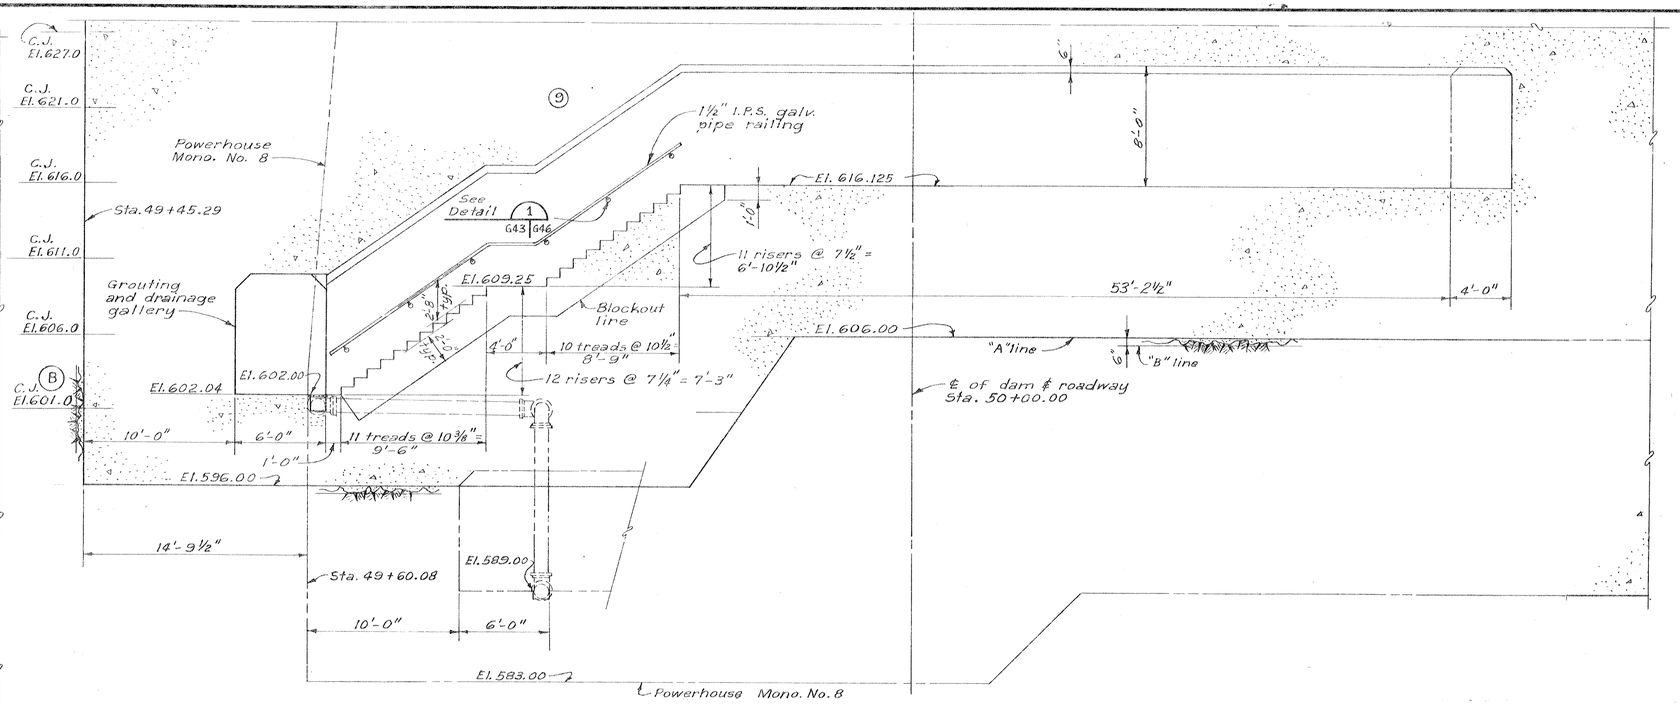

SECTION A
Scale: ¼" = 1'-0"

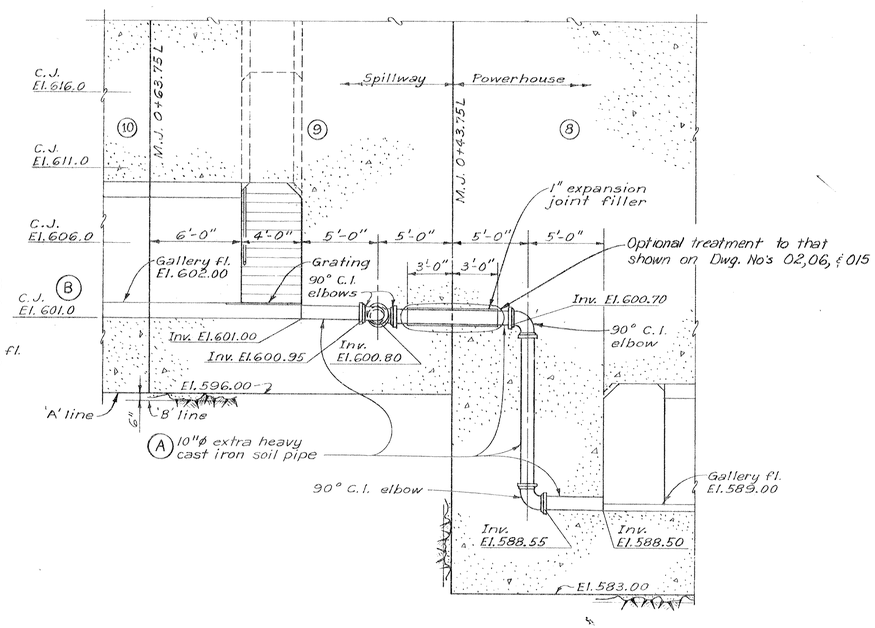

SECTION B
Scale: ¼" = 1'-0"

REFERENCE DWGS.

General Notes – Galleries	G41
Gallery layout	G41
Railings and stair details	G46
Gutter gratings	G47

RECORD DRAWING

JANUARY 1974

CONTRACT NO. DACW41-71-C-0043

SYM.	DESCRIPTION	DATE	APP'D.
	Revised for "As Built" conditions	2/22/84	CBB
Ⓑ	Revised construction joints.	2/22/84	CBB
Ⓐ	Miscellaneous corrections	2/22/84	CBB

REVISIONS

OSAGE RIVER BASIN

KAYSINGER BLUFF RESERVOIR

STAGE III CONSTRUCTION

GALLERIES
MONOLITH NO. 9

Dwg. No. G43

CORPS OF ENGINEERS
KANSAS CITY DISTRICT

Scale: as shown

U. S. ARMY
AUGUST 1970

Submitted: CHIEF, RESERVOIR STRUCTS. SECT.
Recommended: CHIEF, DESIGN BRANCH
Approved: CHIEF, ENGINEERING DIVISION

DESIGNED BY: M.D.J. DRAWN BY: J.A.R. CHECKED BY: M.D.J.

FILE NO. 0-12-1905

O. & M. M. PLATE NO. 232