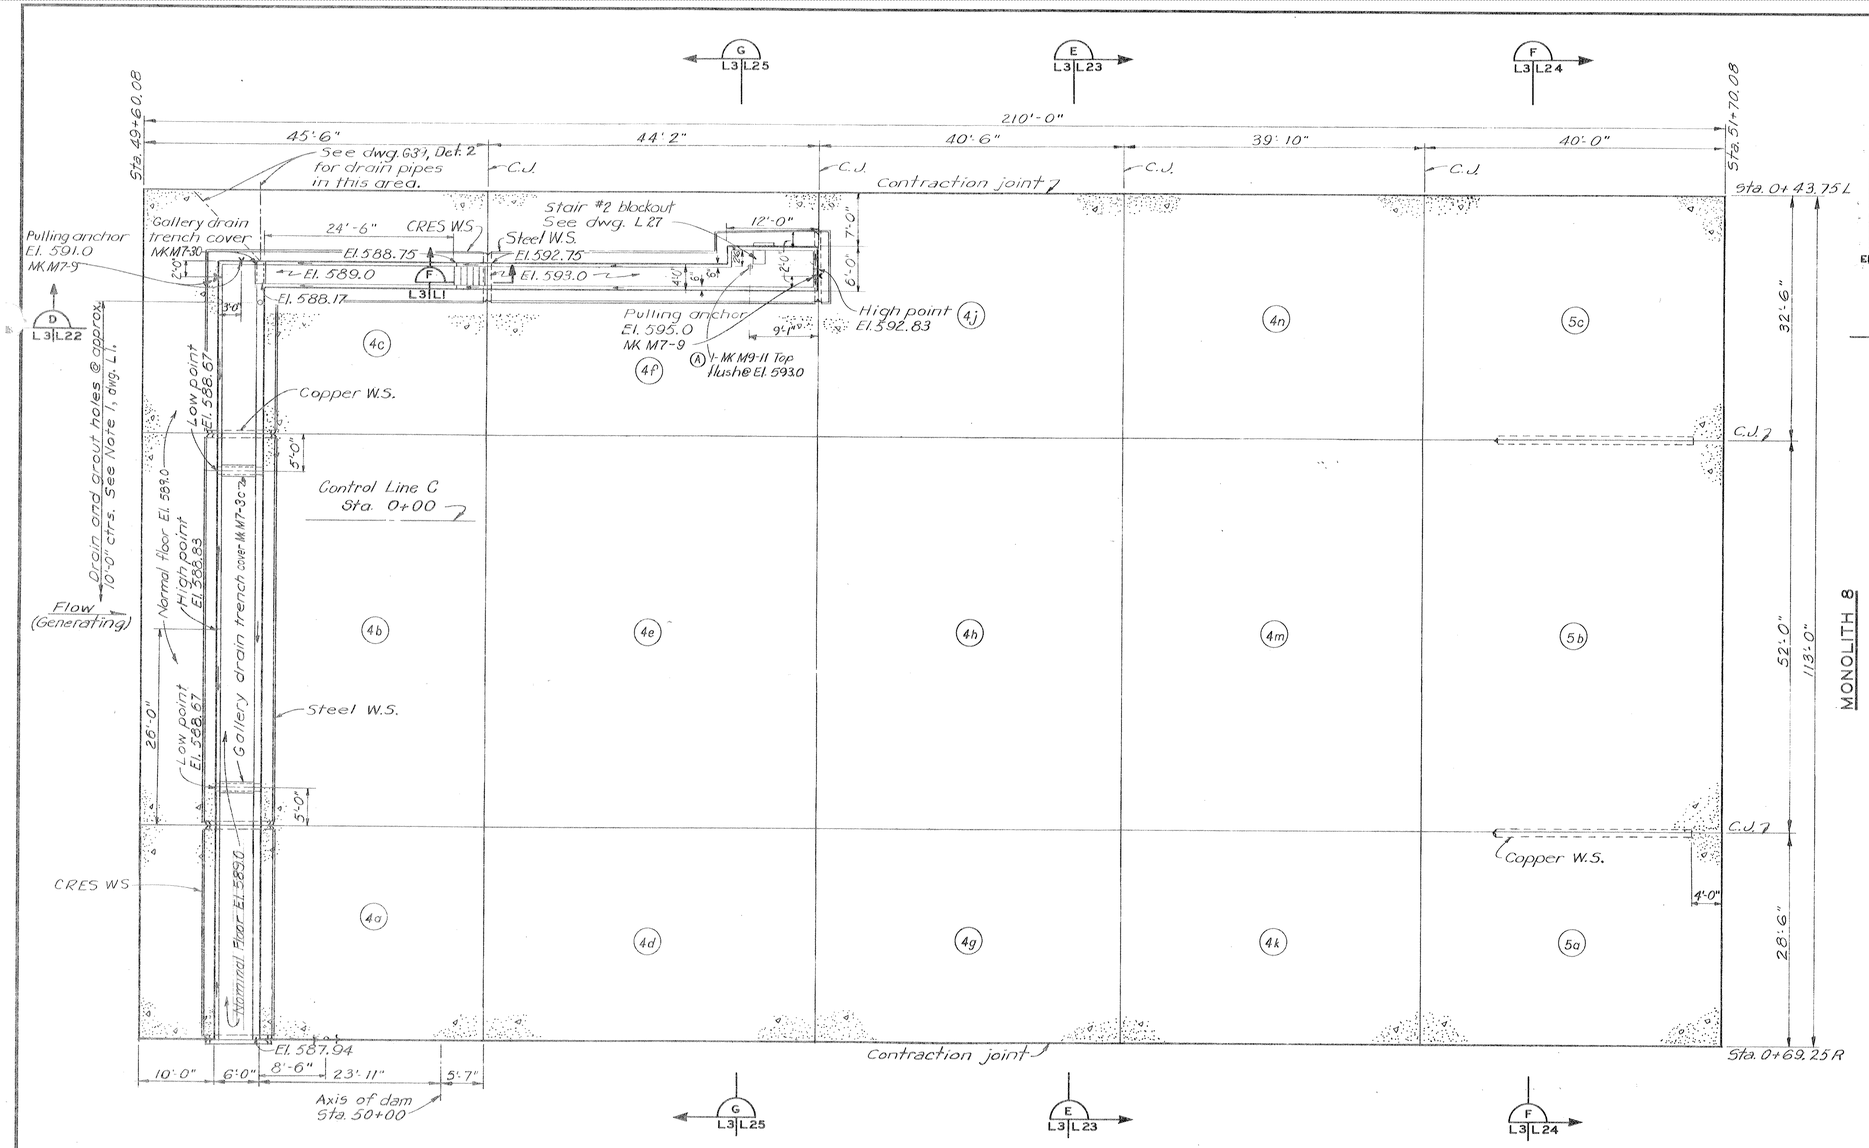

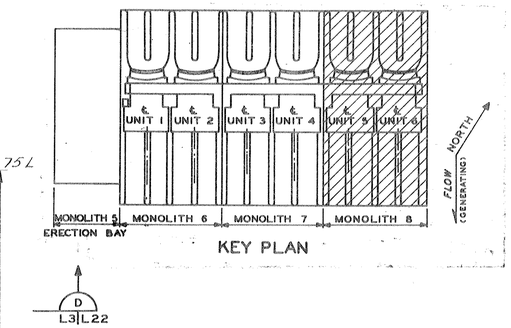

KEY PLAN

NOTES:
1. Work this dwg. with L1, L2 and L22.
2. Gallery floor including stair treads shall be wood float finished. Construction joints in gallery floor and gutter shall be flush.
3. Reinforcement Dwgs. N1, N3, N6, N10, N11, N12.

RECORD DRAWING

JANUARY 1974

CONTRACT NO. DACW41-71-C-0043

SYM.	DESCRIPTION	DATE	APP'D.
	Revised for "As Built" conditions	2/22/74	[illegible]
(A)	Add 1-MK M9-11 plate	6-18-71	[illegible]

REVISIONS

OSAGE RIVER

KAYSINGER BLUFF RESERVOIR

STAGE III CONSTRUCTION

POWERHOUSE SUBSTRUCTURE

GENERATOR MONOLITH

PLAN EL. 594.0 – UNITS 5 & 6

Dwg. No. L3

Scale: as shown

U. S. ARMY ENGINEER DISTRICT, KANSAS CITY, MO.

AUG. 1970

PREPARED BY U. S. ARMY ENGINEER DISTRICT, OMAHA, NEBRASKA

Submitted: [signature] CHIEF, DESIGN BRANCH USED OMAHA

Recommended: [signature] CHIEF, DESIGN BRANCH USED KANSAS CITY

Approved: [signature] CHIEF, ENGINEERING DIVISION USED KANSAS CITY

DESIGNED BY: G.D.H./O.F.S. DRAWN BY: R.C.R. CHECKED BY: J.O.C.

FILE NO. 0-12-2019

O. & M. M. PLATE NO. 329