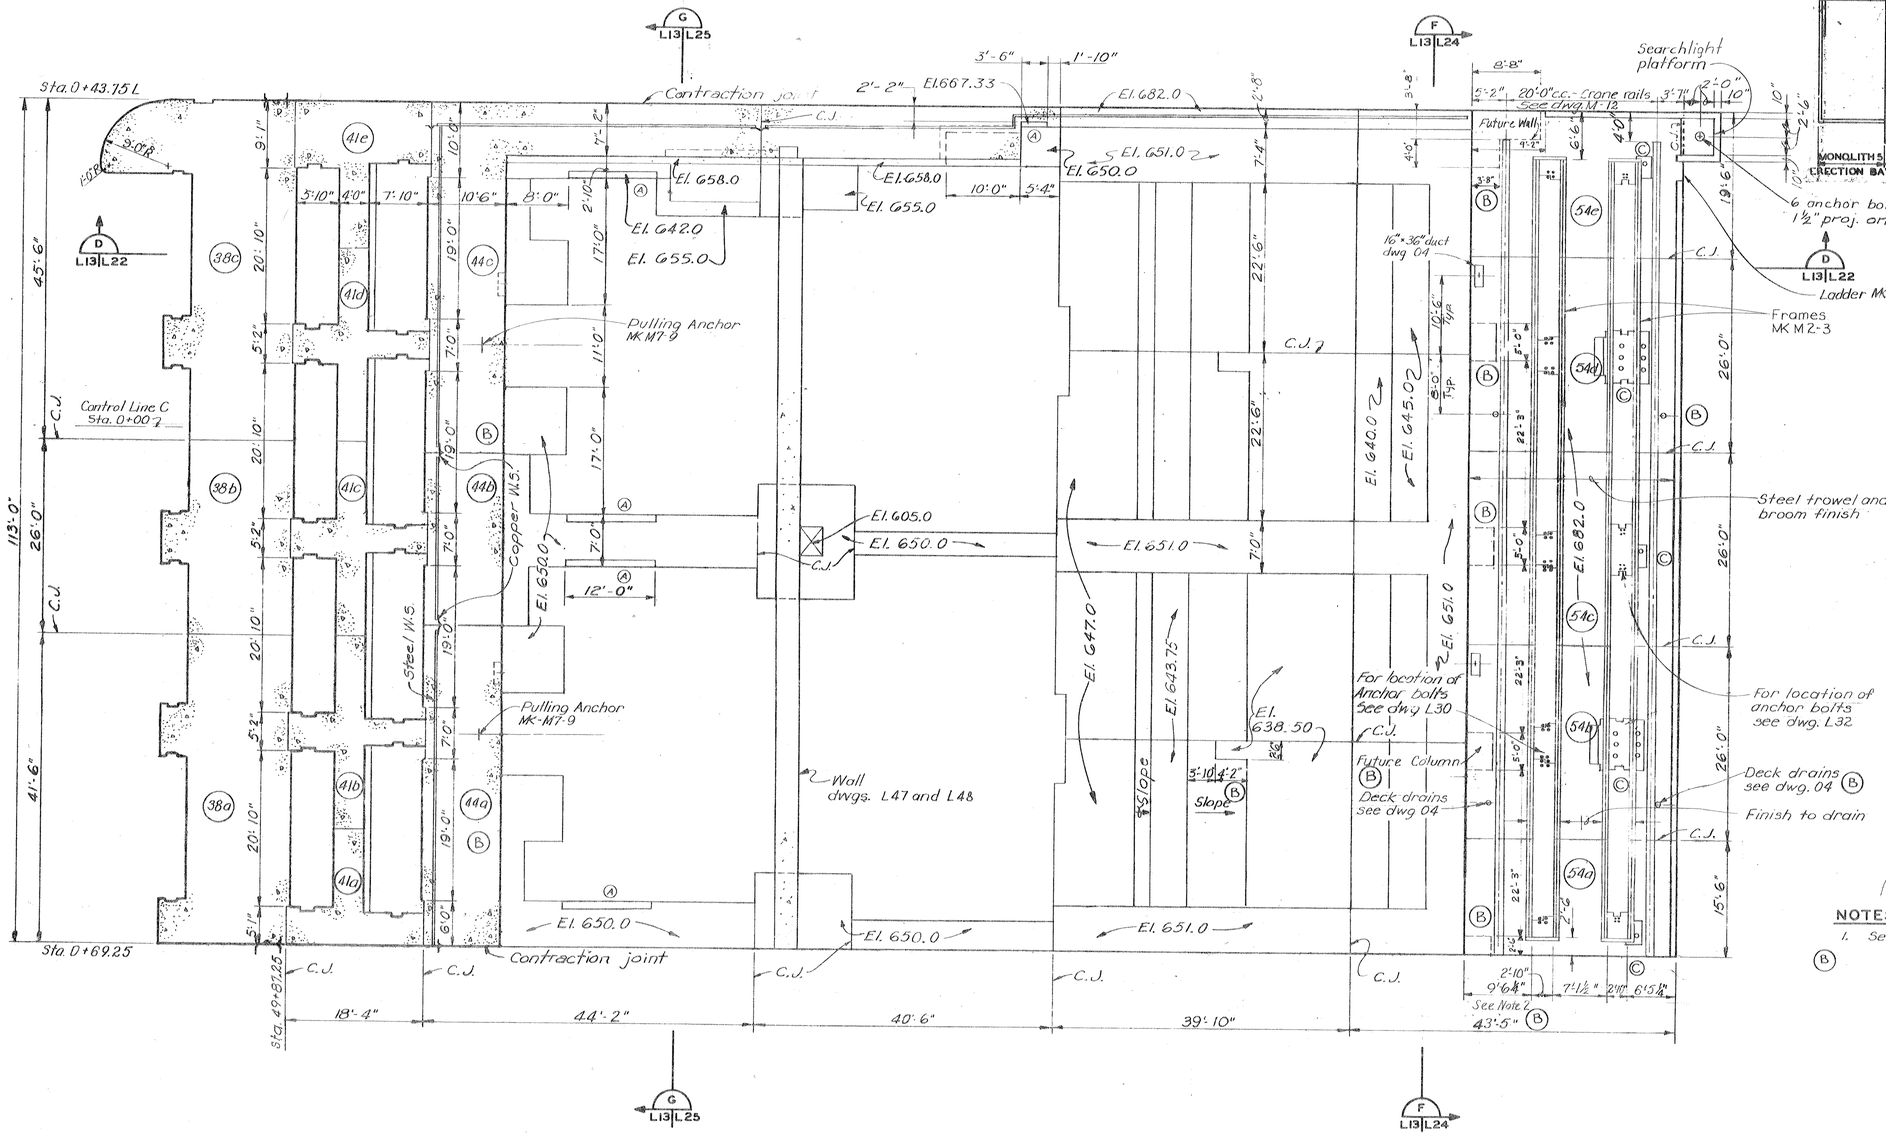

NOTES:

1. See Notes dwg. L11.

REFERENCE DRAWINGS:

Concrete: L11, L13, L17, L22, L24 & L25
Reinforcement: N7, N3 thru N6 and N12.

SYM.	DESCRIPTION	DATE	APP'D.
	Revised for "As Built" conditions	[illegible]	[illegible]
C	Added blockouts and pipes	3-19-71	[illegible]
B	Added Column Location, Note 2, Misc. Corrections	7-28-72	[illegible]
A	Revised block-out C wall key dimens.	[illegible]	[illegible]

REVISIONS

OSAGE RIVER

KAYSINGER BLUFF RESERVOIR

STAGE III CONSTRUCTION

POWERHOUSE SUBSTRUCTURE

GENERATOR MONOLITH

PLAN EL. 682.0 – UNITS 5 & 6

Dwg. No. L13 — Scale: as shown

U. S. ARMY ENGINEER DISTRICT, KANSAS CITY, MO. — AUG. 1970

PREPARED BY U. S. ARMY ENGINEER DISTRICT, OMAHA, NEBRASKA

Submitted: CHIEF, DESIGN BRANCH USED OMAHA — Recommended: CHIEF, DESIGN BRANCH USED KANSAS CITY — Approved: CHIEF, ENGINEERING DIVISION USED KANSAS CITY

DESIGNED BY: G.D.H./O.F.S. — DRAWN BY: R.C.R. — CHECKED BY: J.O.C.

FILE NO. 0-12-2029

RECORD DRAWING

JANUARY 1974

CONTRACT NO. DACW41-71-C-0043

O. & M. M. PLATE NO. 339