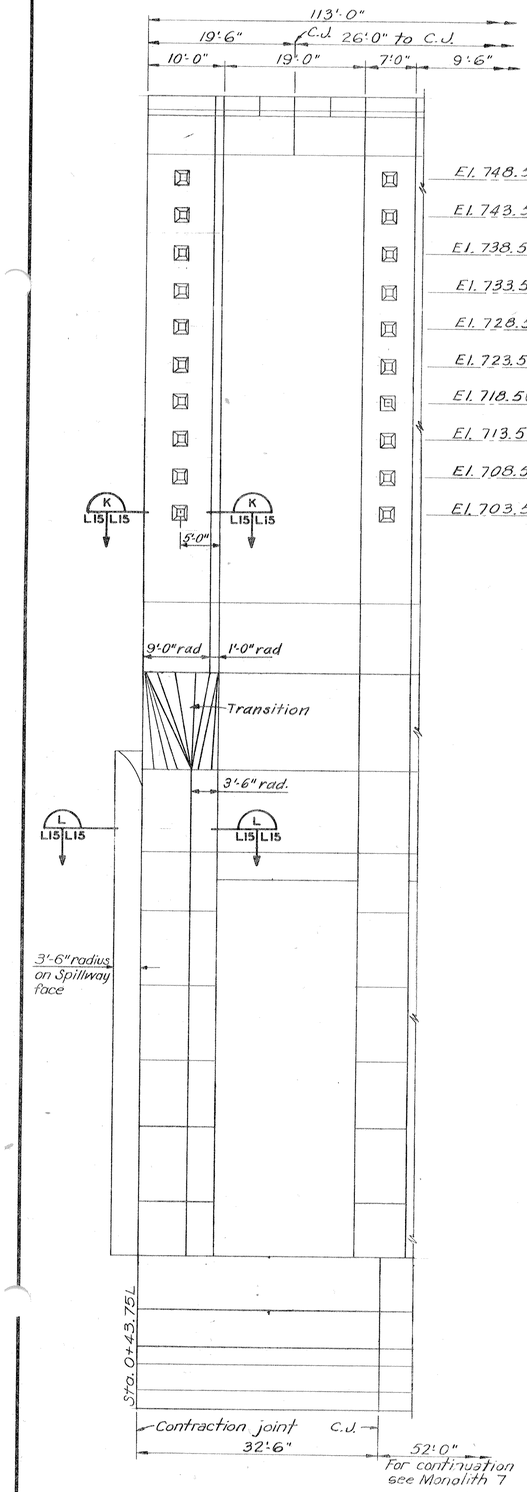

MONOLITH 8

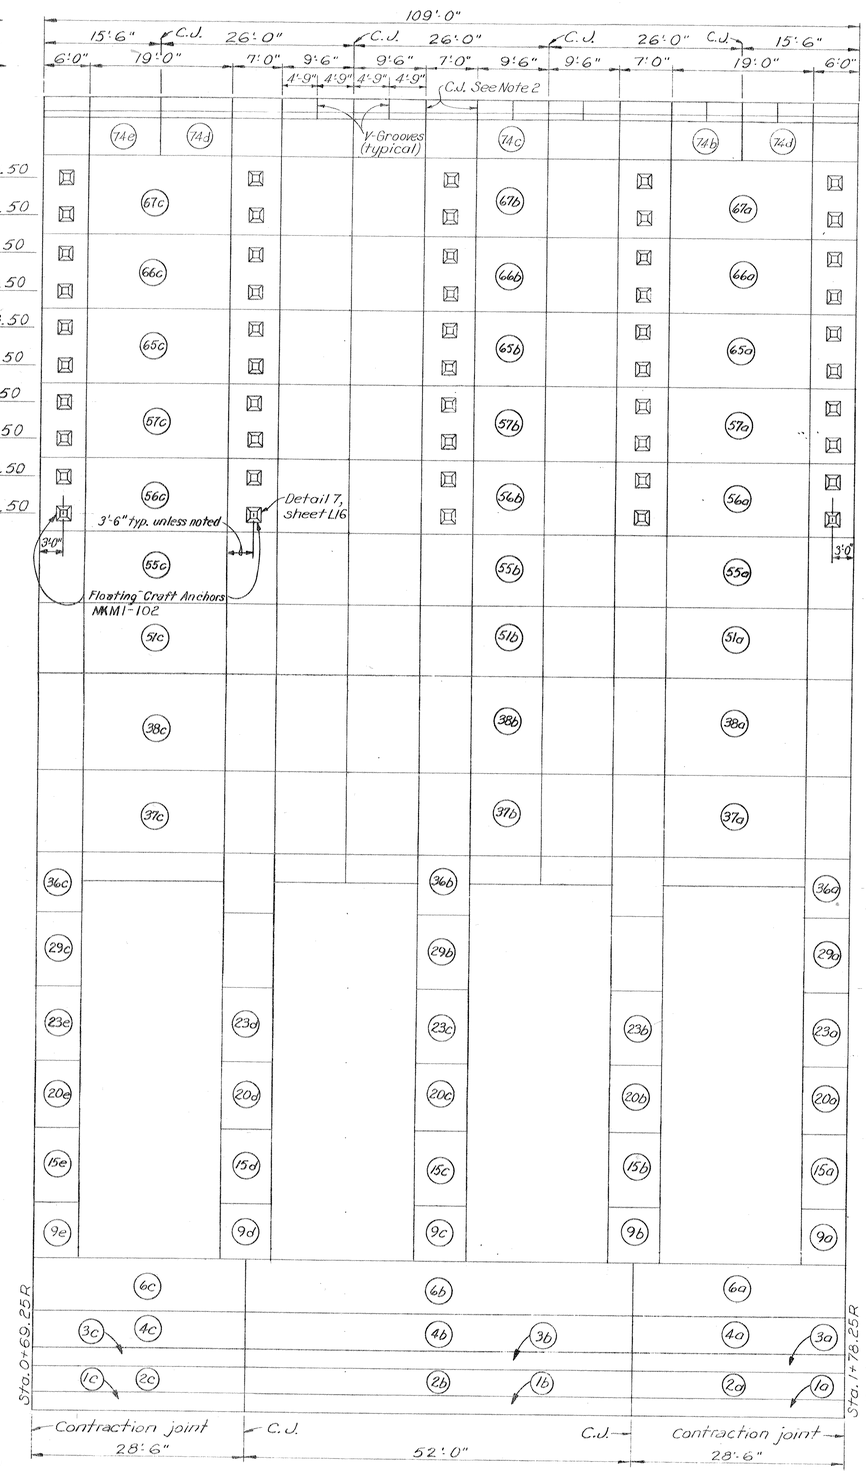

MONOLITH 7

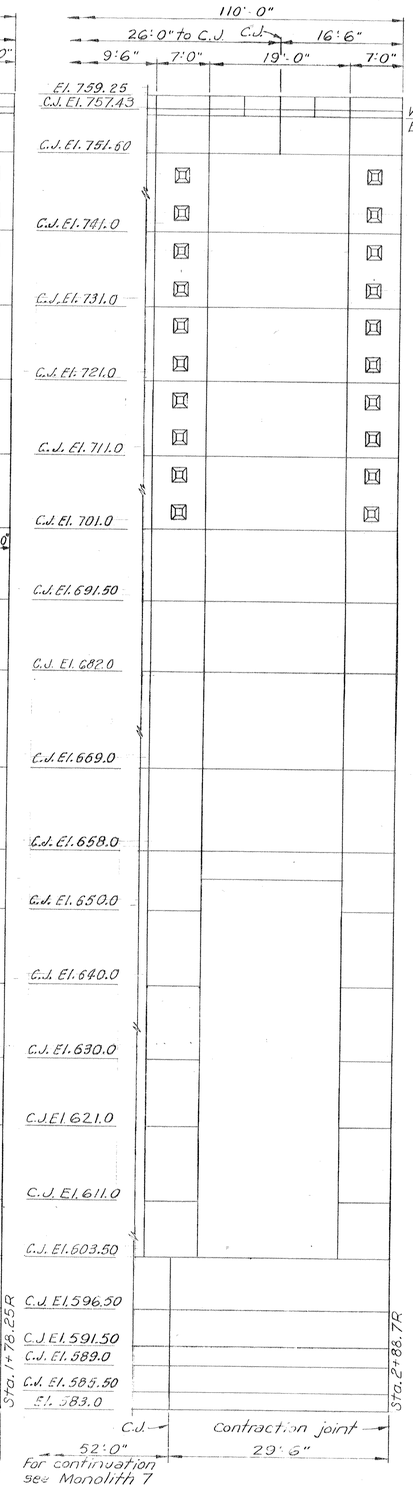

MONOLITH 6

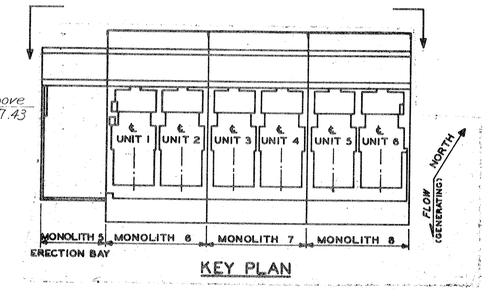

KEY PLAN

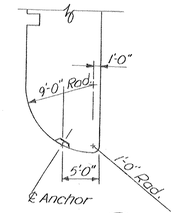

SECTION K L15 L15

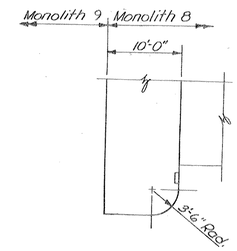

SECTION L L15 L15

NOTES:

1. Do not install floating craft anchors in right pier of monolith 8 and left pier of monolith 6.
2. Parapet and pours on intake deck are shown on dwg. G16.
3. All joints below elevation 701.0 shall be flush. Concrete finish above elevation 701.0 shall be class "A".
4. Reinforcement dwg. N5.

RECORD DRAWING

JANUARY 1974

CONTRACT NO. DACW41-71-C-0043

SYM.	DESCRIPTION	DATE	APP'D.
	Revised for "As Built" conditions	[illegible]	[illegible]

REVISIONS

OSAGE RIVER

KAYSINGER BLUFF RESERVOIR

STAGE III CONSTRUCTION

POWERHOUSE SUBSTRUCTURE

GENERATOR MONOLITHS
UPSTREAM ELEVATION

Dwg. No. L15 — Scale: as shown

U. S. ARMY ENGINEER DISTRICT, KANSAS CITY, MO. — AUG. 1970

PREPARED BY U. S. ARMY ENGINEER DISTRICT, OMAHA, NEBRASKA

Submitted: CHIEF, DESIGN BRANCH USED OMAHA — Recommended: CHIEF, DESIGN BRANCH USED KANSAS CITY — Approved: CHIEF, ENGINEERING DIVISION USED KANSAS CITY

DESIGNED BY: G.D.H./O.F.S. — DRAWN BY: — CHECKED BY: J. O. C. — FILE NO. 0-12-2031

O. & M. M. PLATE NO. 341