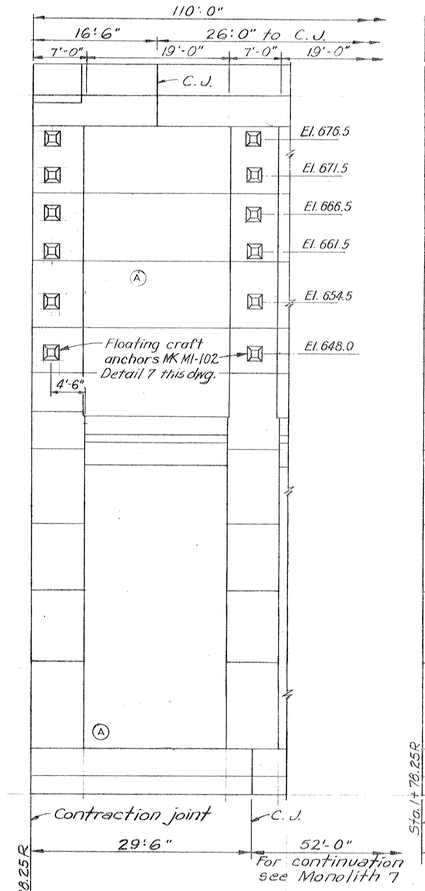

MONOLITH 6

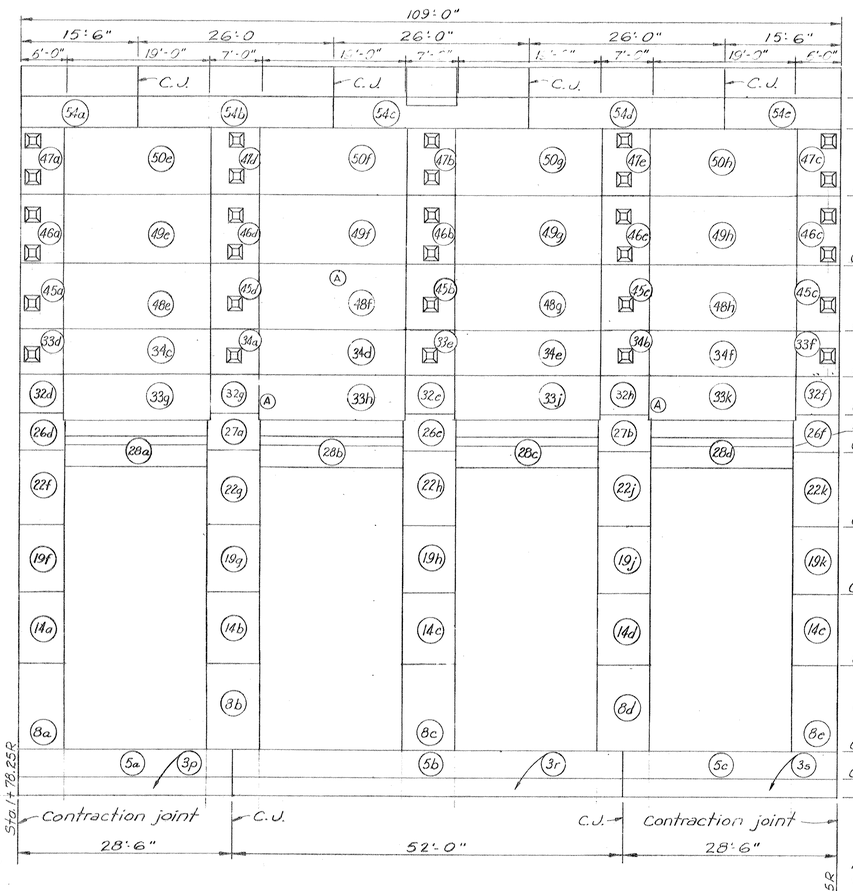

MONOLITH 7

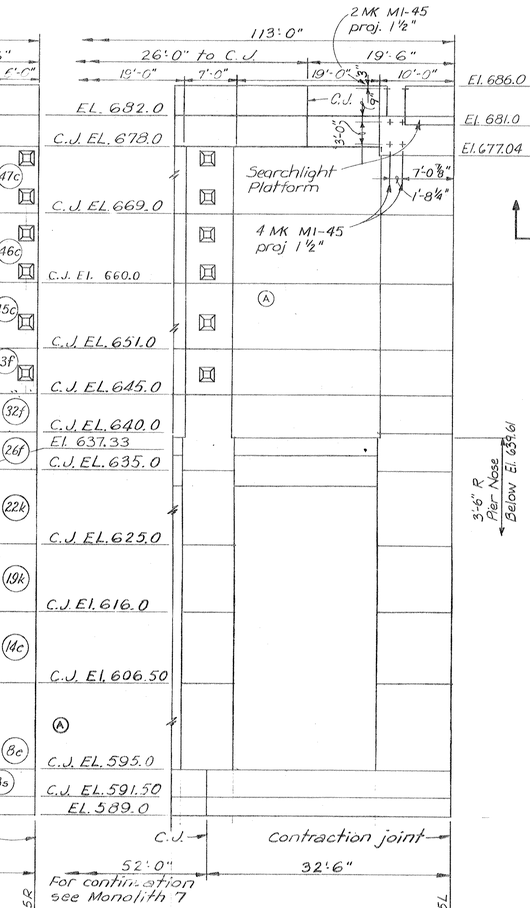

MONOLITH 8

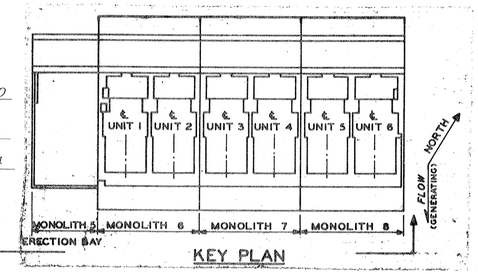

KEY PLAN

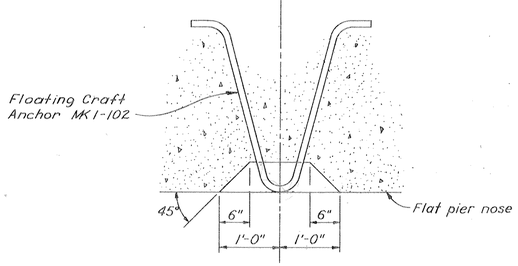

PLAN

TYP. FOR ALL ANCHORS EXCEPT AS NOTED

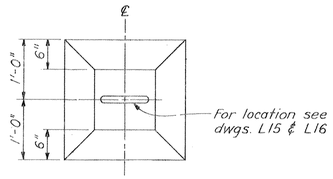

ELEVATION

DETAIL 7

SCALE: 1 INCH = 1 FOOT

12" 6" 0 1'

SCALE ⅛ INCH=1 FOOT

12 0 5 10 15

NOTES:

1. Do not install floating craft anchors in conc. pours 33f, 45c, 46c & 47c of Monolith 6.
2. Do not install floating craft anchors in conc. pours 33d, 45a, 46a & 47a of Monolith 8.
3. Joints below El. 658.0 shall be flush.
4. Reinforcement dwg. N12.
5. V-Groove are required for...
   Horiz. Joints @ El. 682.0
   Vert. Joints from El. 678.0 to El. 686.0

RECORD DRAWING

JANUARY 1974

CONTRACT NO. DACW41-71-C-0043

SYM.	DESCRIPTION	DATE	APP'D.
	Revised for "As Built" conditions	[illegible]	[illegible]
A	Revised joints and lift numbers.	4-24-71	[illegible]

REVISIONS

OSAGE RIVER

KAYSINGER BLUFF RESERVOIR

STAGE III CONSTRUCTION

POWERHOUSE SUBSTRUCTURE

GENERATOR MONOLITHS

DOWNSTREAM ELEVATION

Dwg. No. L16 — Scale: as shown

U. S. ARMY ENGINEER DISTRICT, KANSAS CITY, MO. — AUG. 1970

PREPARED BY U. S. ARMY ENGINEER DISTRICT, OMAHA, NEBRASKA

Submitted: [signature] CHIEF, DESIGN BRANCH USED OMAHA

Recommended: [signature] CHIEF, DESIGN BRANCH USED KANSAS CITY

Approved: [signature] CHIEF, ENGINEERING DIVISION USED KANSAS CITY

DESIGNED BY: O.F.S. DRAWN BY: CHECKED BY: J.O.C.

FILE NO. 0-12-2032

SAFETY PAYS

O. & M. M. PLATE NO. 342