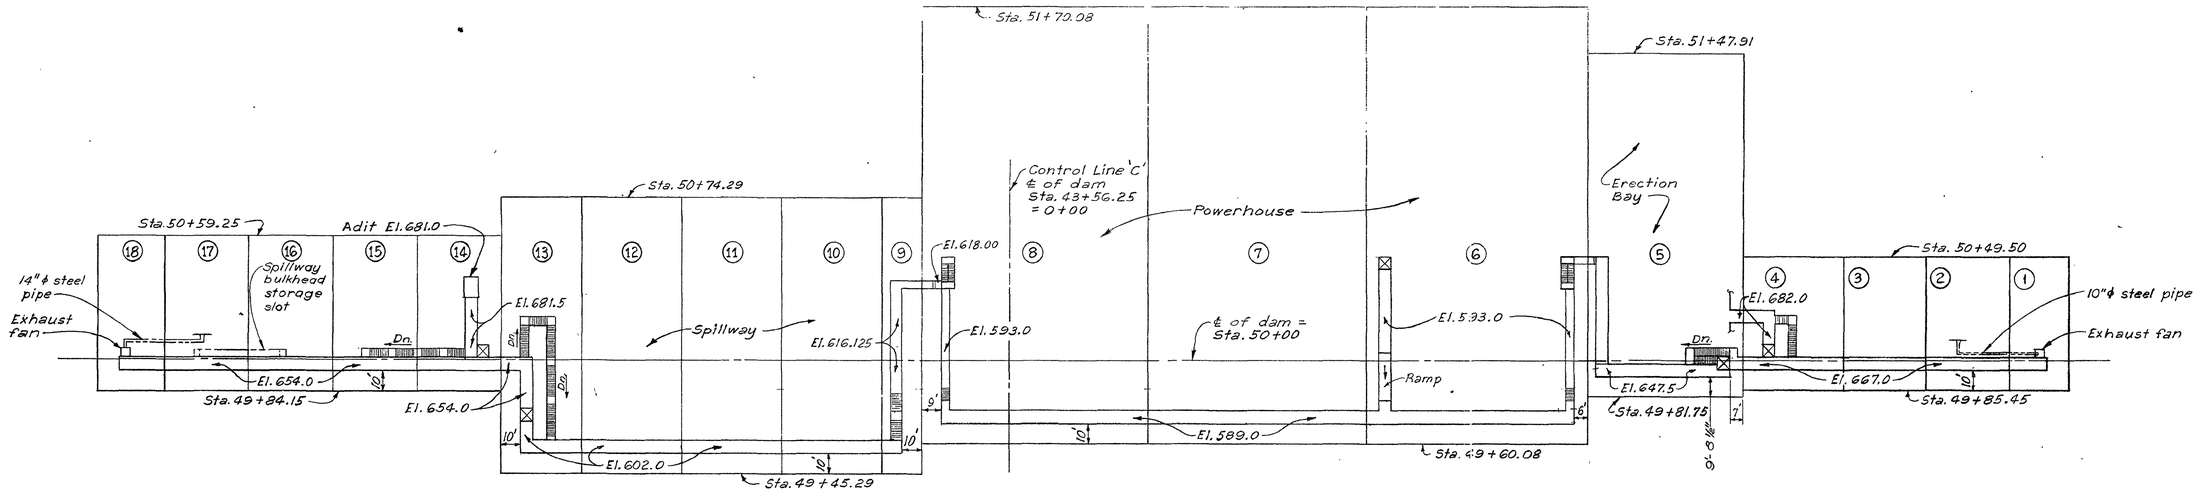

PLAN OF GALLERIES

Scale: 1" = 30'-0"

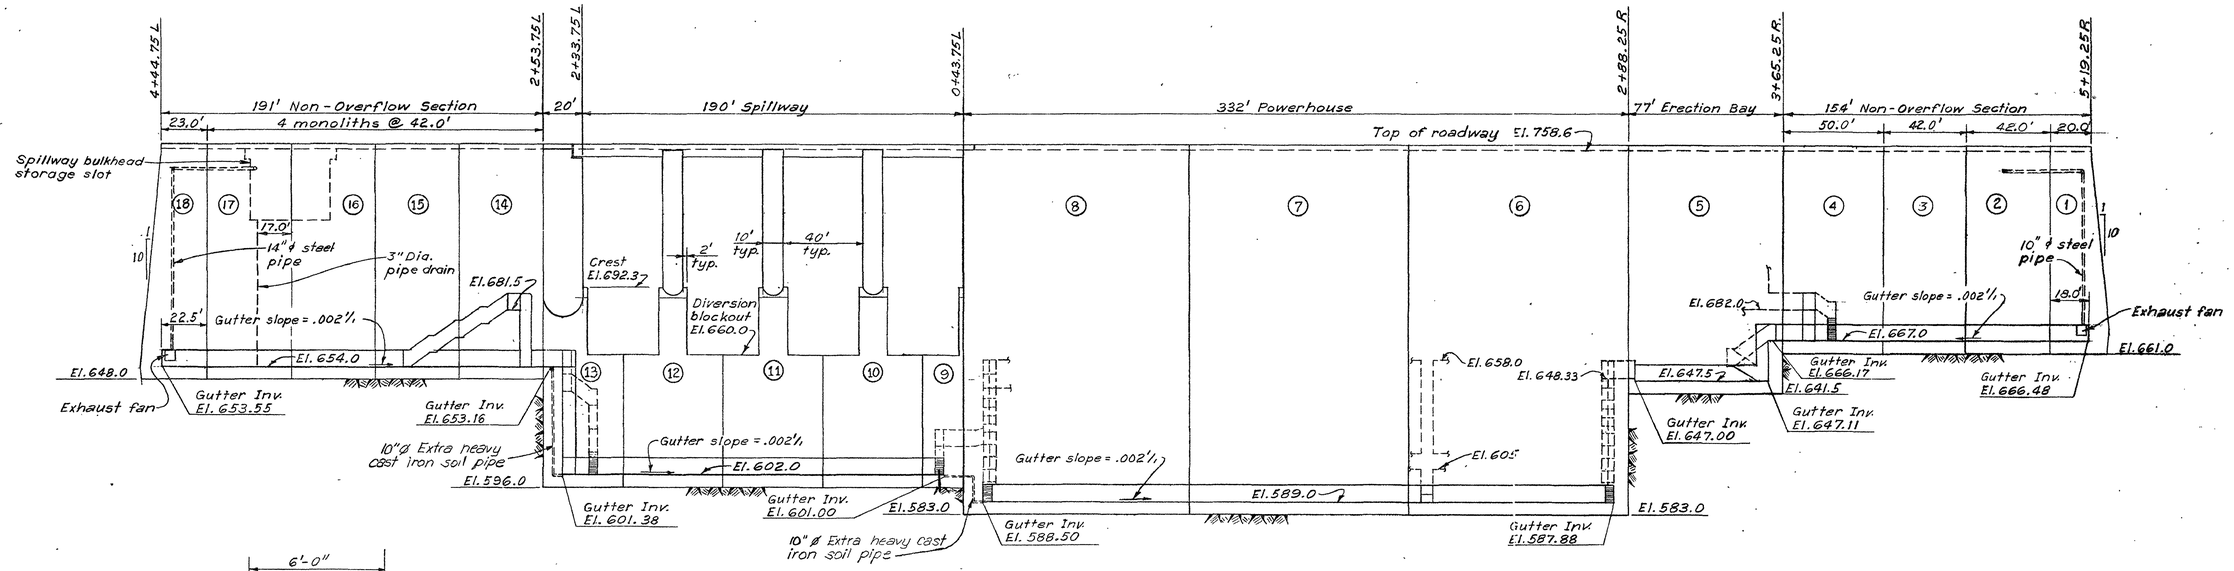

PROFILE OF GALLERIES

Scale: 1" = 30'-0"

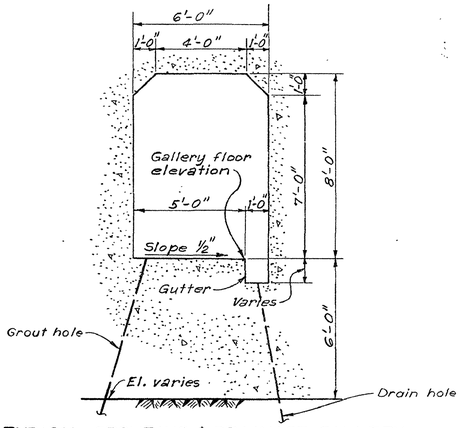

TYPICAL GROUTING & DRAINAGE GALLERY

Scale: 3/8" = 1'-0"

GENERAL NOTES – GALLERIES

All exposed edges of concrete shall be chamfered ¾" unless otherwise noted.

Concrete dimensions and reinforcement clearance are to "A" line of excavation.

CJ – Construction joint with reinforcement continuous thru joint unless otherwise shown.

MJ – Monolith joint with reinforcement not continuous thru joint.

All gratings and railings shall be galvanized after fabrication.

REFERENCE DWGS.

Non-Overflow Bulkheads ____ G11
Spillway ____ G18
Waterstops & drains ____ G38, G39
Electrical ____ G48

RECORD DRAWING

JANUARY 1974

CONTRACT NO DACW41-71-C-0043

SYM.	DESCRIPTION	DATE	APPD.
	Revised for "As Built" conditions		

REVISIONS

OSAGE RIVER BASIN

KAYSINGER BLUFF RESERVOIR

STAGE III CONSTRUCTION

GALLERIES GENERAL LAYOUT

Dwg No G41

CORPS OF ENGINEERS
KANSAS CITY DISTRICT

Scale: as shown

U. S. ARMY
AUGUST 1970

Submitted: CHIEF, RESERVOIR STRUCTS SECT
Recommended: CHIEF, DESIGN BRANCH
Approved: CHIEF, ENGINEERING DIVISION

DESIGNED BY M.D.J. DRAWN BY J.A.R. CHECKED BY M.D.J.

0-12-1903

O & M.M. PLATE NO. 230

HST00230.dgn 04/23/2004 10:01:35 AM