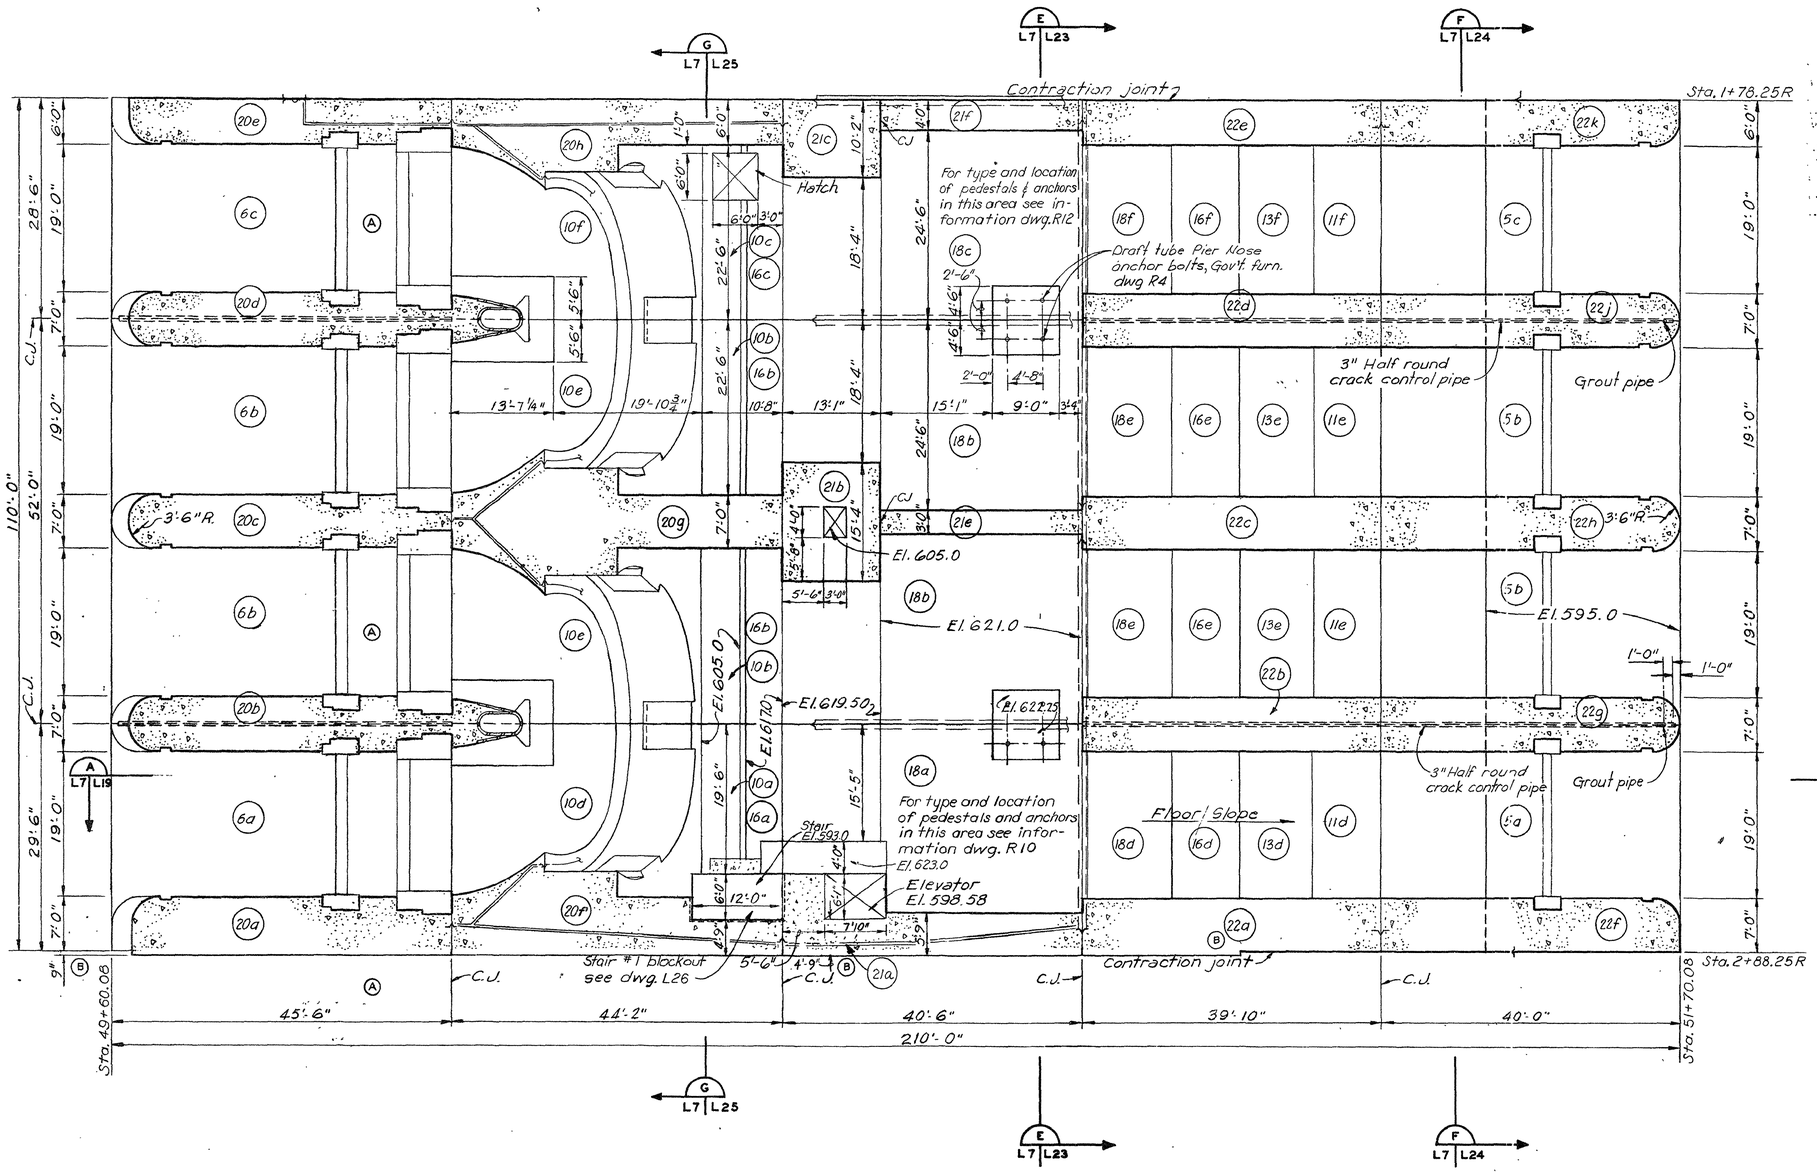

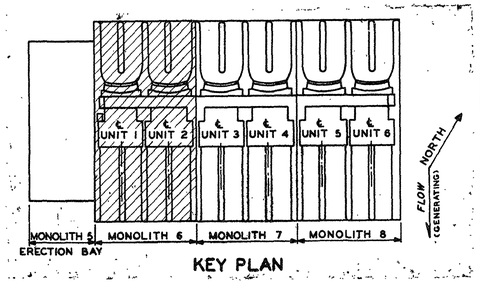

KEY PLAN

MONOLITH NO. 6

REFERENCE DRAWINGS:

Concrete	L8, L9, L19, L23, L24, L25
Structural Excavation	B13, B2, B3
Draft Tube Outline	K12, K13
Pour Layout	K4, K5, K6
Reinforcement	N1, N2, N3, N6, N10, N12, N13
Embedded Piping & Ductwork	O1, O2, O5, O6
Installation of Gov't. Furn. Equip.	L1 thru L13
Standard Details & General Notes	K16
Electrical	P3, P5
Intake Water Passage Outline	K14, K15
Intake Trashracks Frames	L31
Draft Tube Trashracks Frames	L32
Intake Bulkhead Anchors	L29
Intake Gate Anchors	L28
Draft Tube Bulkhead Anchors	L30
Stairway Details	L26, L27

SYM.	DESCRIPTION	DATE	APP'D.
	Revised for "As Built" conditions	2/22/84	
B	Revised Concrete Outline	9-29-71	
A	DELETE C.J. AND REVISE LIFT NOS.	9-29-71	

REVISIONS

OSAGE RIVER

KAYSINGER BLUFF RESERVOIR

STAGE III CONSTRUCTION

POWERHOUSE SUBSTRUCTURE

GENERATOR MONOLITH

PLAN EL. 630.0 - UNITS 1 & 2

Dwg. No. L7 — Scale: as shown

U. S. ARMY ENGINEER DISTRICT, KANSAS CITY, MO. — AUG. 1970

PREPARED BY U. S. ARMY ENGINEER DISTRICT, OMAHA, NEBRASKA

Submitted: CHIEF, DESIGN BRANCH USED OMAHA — Recommended: CHIEF, DESIGN BRANCH USED KANSAS CITY — Approved: CHIEF, ENGINEERING DIVISION USED KANSAS CITY

DESIGNED BY: G.D.H./D.F.S. — DRAWN BY: R.C.R. — CHECKED BY: J.O.C. — FILE NO 0-12-2023

RECORD DRAWING

JANUARY 1974

CONTRACT NO. DACW41-71-C-0043

O. & M. M. PLATE NO. 333

HST00333.dgn 04/23/2004 10:04:32 AM