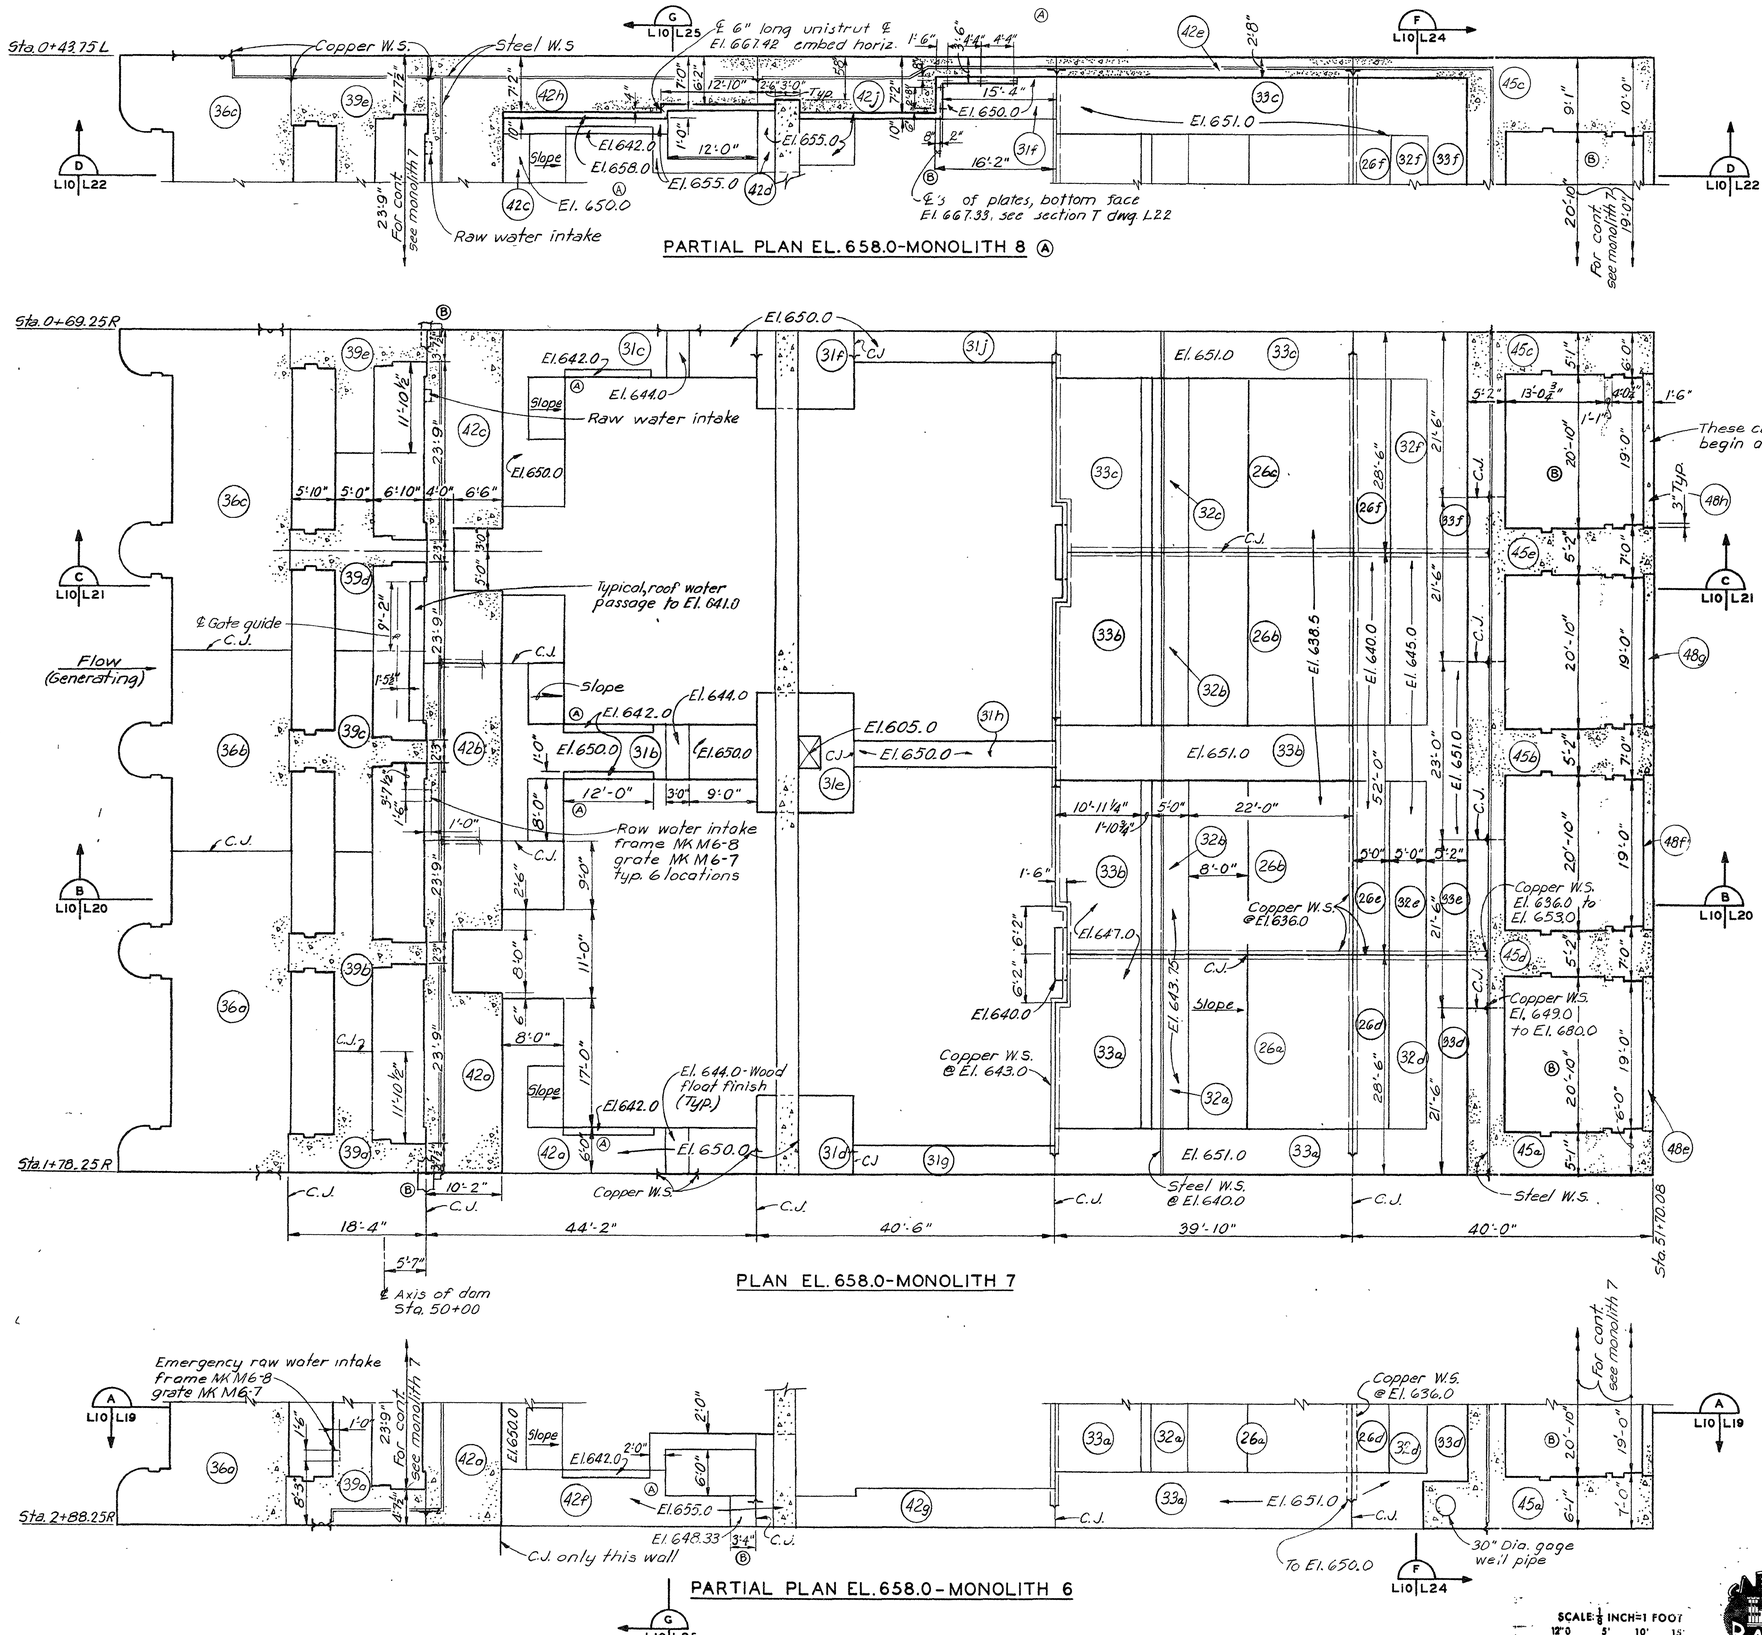

REFERENCE DRAWINGS:

Structural Excavation	B13, B2, B3
Pour Layout	K4, K5, K6
Reinforcement	N3, N5, N6, N7, N11, N12
Miscellaneous Metals	M6
Embedded Piping & Ductwork	01, 03, 06, 07, 08, 09
Standard Details & General Notes	K16
Electrical	P12, P13, P14, P17, P18, P19
Intake Trashrack Frames	L31
Draft Tube Trashrack Frames	L32
Intake Bulkhead Anchors	L29
Intake Gate Anchors	L28
Draft Tube Bulkhead Anchors	L30
Stairway Details	L26, L27

NOTES:

1. Work this drawing with L19 thru L25.

RECORD DRAWING

JANUARY 1974

CONTRACT NO. DACW41-71-C-0043

SYM.	DESCRIPTION	DATE	APP'D.
	"Revised for "As Built" conditions	4-2-84	[illegible]
(B)	Delete wall, revise misc.	8-9-72	[illegible]
	[illegible]	[illegible]	[illegible]

REVISIONS

OSAGE RIVER

KAYSINGER BLUFF RESERVOIR

STAGE III CONSTRUCTION

POWERHOUSE SUBSTRUCTURE

GENERATOR MONOLITH

PLAN EL. 658.0

Dwg. No. L10 — Scale: as shown

U. S. ARMY ENGINEER DISTRICT, KANSAS CITY, MO — AUG. 1970

PREPARED BY U. S. ARMY ENGINEER DISTRICT, OMAHA, NEBRASKA

Submitted: CHIEF, DESIGN BRANCH USED OMAHA — Recommended: CHIEF, DESIGN BRANCH USED KANSAS CITY — Approved: CHIEF, ENGINEERING DIVISION USED KANSAS CITY

DESIGNED BY: G.D.H./O.F.S. — DRAWN BY: R.C.R. — CHECKED BY: J.O.C. — FILE NO.

0-12-2026

O. & M. M. PLATE NO. 336

HSTOD336.dgn 04/23/2004 10:05:12 AM