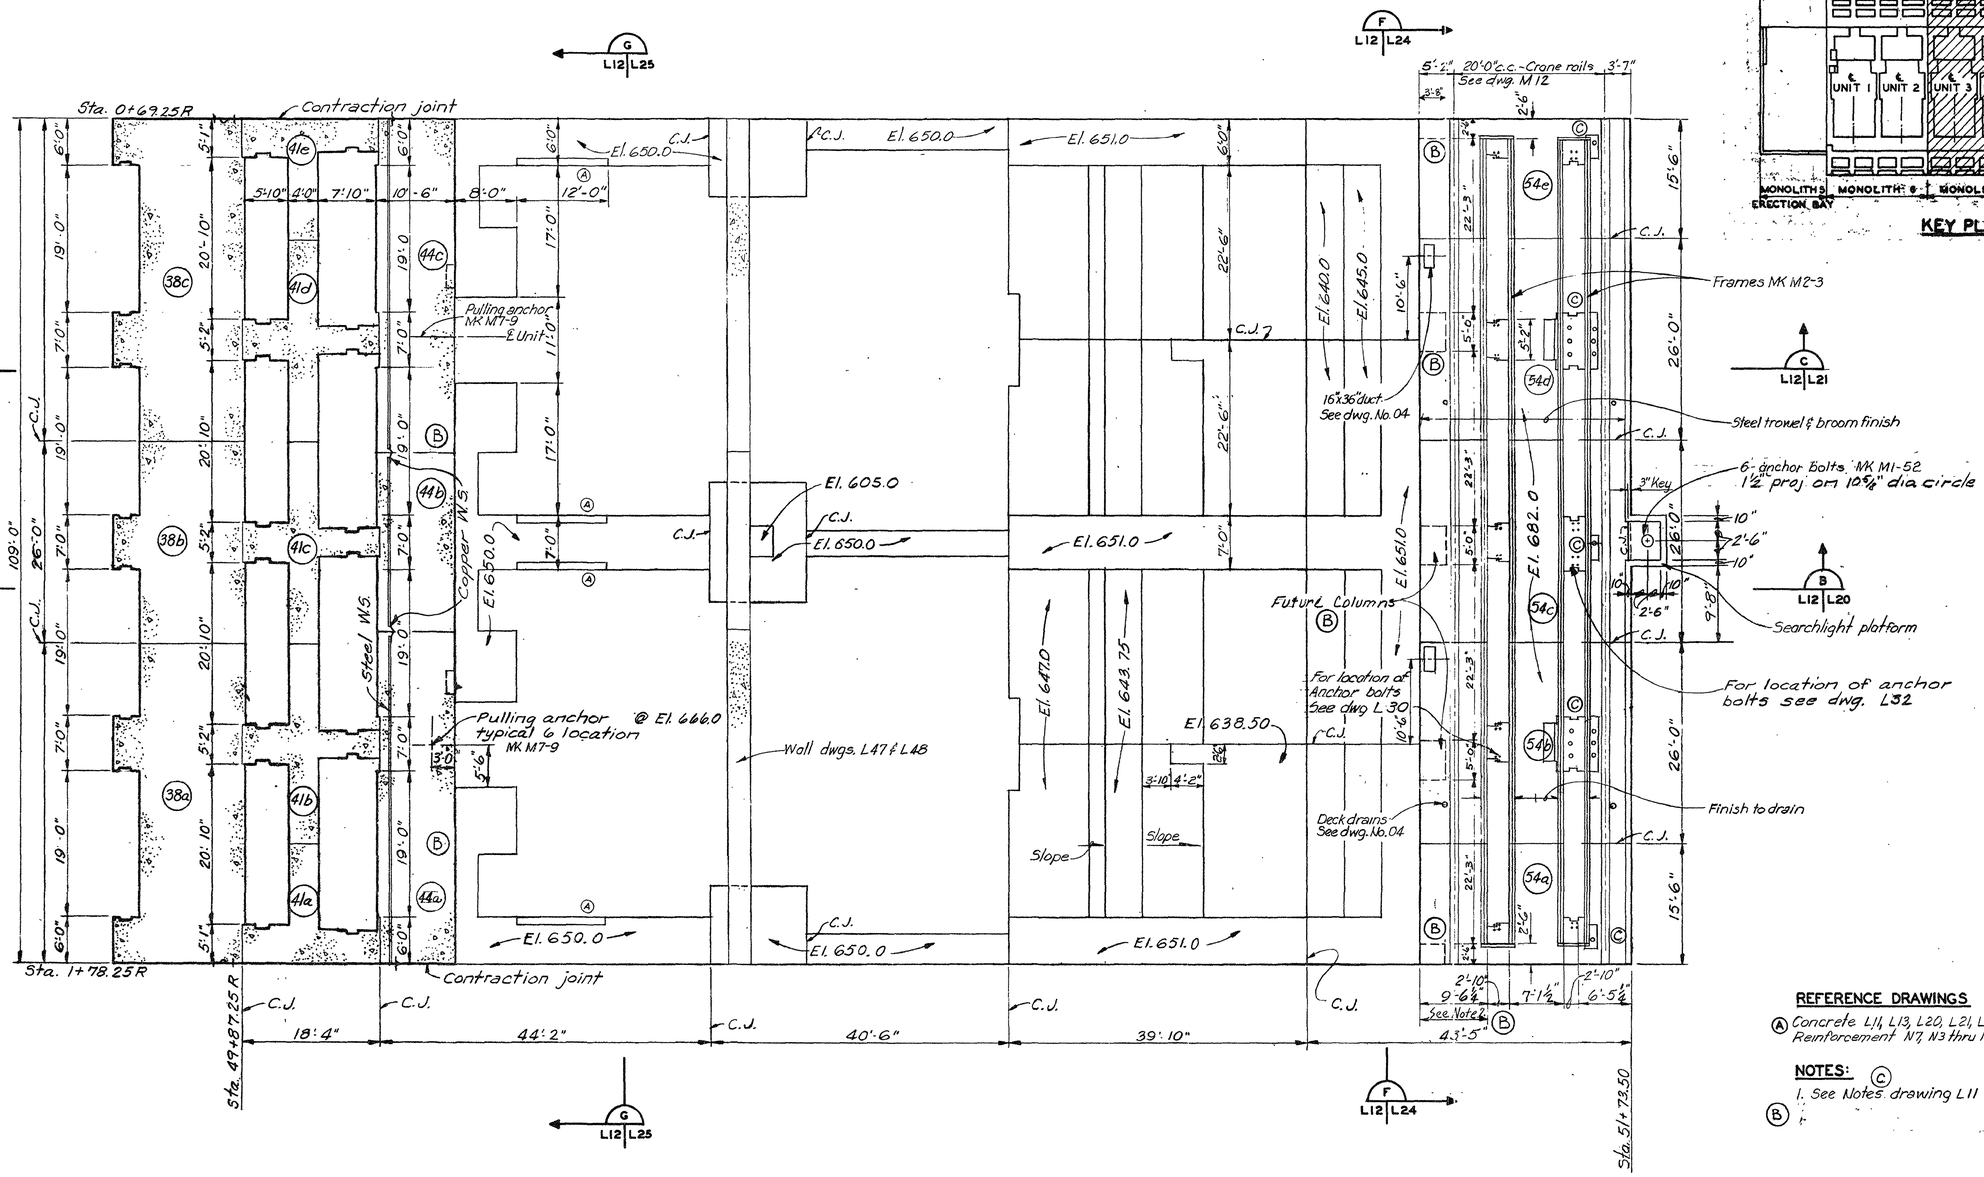

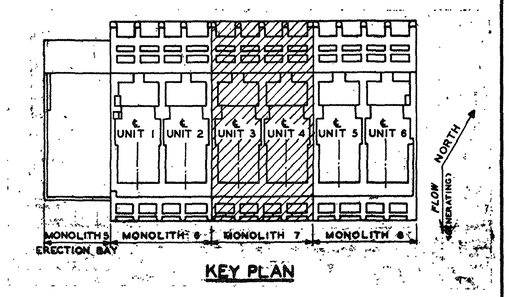

KEY PLAN

REFERENCE DRAWINGS

(A) Concrete L11, L13, L20, L21, L24 and L25
Reinforcement N7, N3 thru N6 and N12

NOTES: (C)

1. See Notes drawing L11

(B)

RECORD DRAWING

JANUARY 1974

CONTRACT NO. DACW41-71-C-0043

SYM.	DESCRIPTION	DATE	APP'D.
	Revised for "As Built" conditions	2/22/74	[illegible]
(C)	Added blockouts and pipes.	3-19-73	[illegible]
(3)	Added Column Locations, Note 2, Misc. Correction	7-28-72	[illegible]
(A)	Revised blockout dimension	2-1-7.	[illegible]

REVISIONS

OSAGE RIVER

KAYSINGER BLUFF RESERVOIR

STAGE III CONSTRUCTION

POWERHOUSE SUBSTRUCTURE

GENERATOR MONOLITH

PLAN EL. 682.0 - UNITS 3 & 4

Dwg. No. L12 — Scale: as shown

U. S. ARMY ENGINEER DISTRICT, KANSAS CITY, MO. — AUG. 1970

PREPARED BY U. S. ARMY ENGINEER DISTRICT, OMAHA, NEBRASKA

Submitted: CHIEF, DESIGN BRANCH USED OMAHA — Recommended: CHIEF, DESIGN BRANCH USED KANSAS CITY — Approved: CHIEF, ENGINEERING DIVISION USED KANSAS CITY

DESIGNED BY: GDH/OFS — DRAWN BY: R.C.R. — CHECKED BY: J.O.C. — FILE NO. 0-12-2028

O. & M. M. PLATE NO. 338