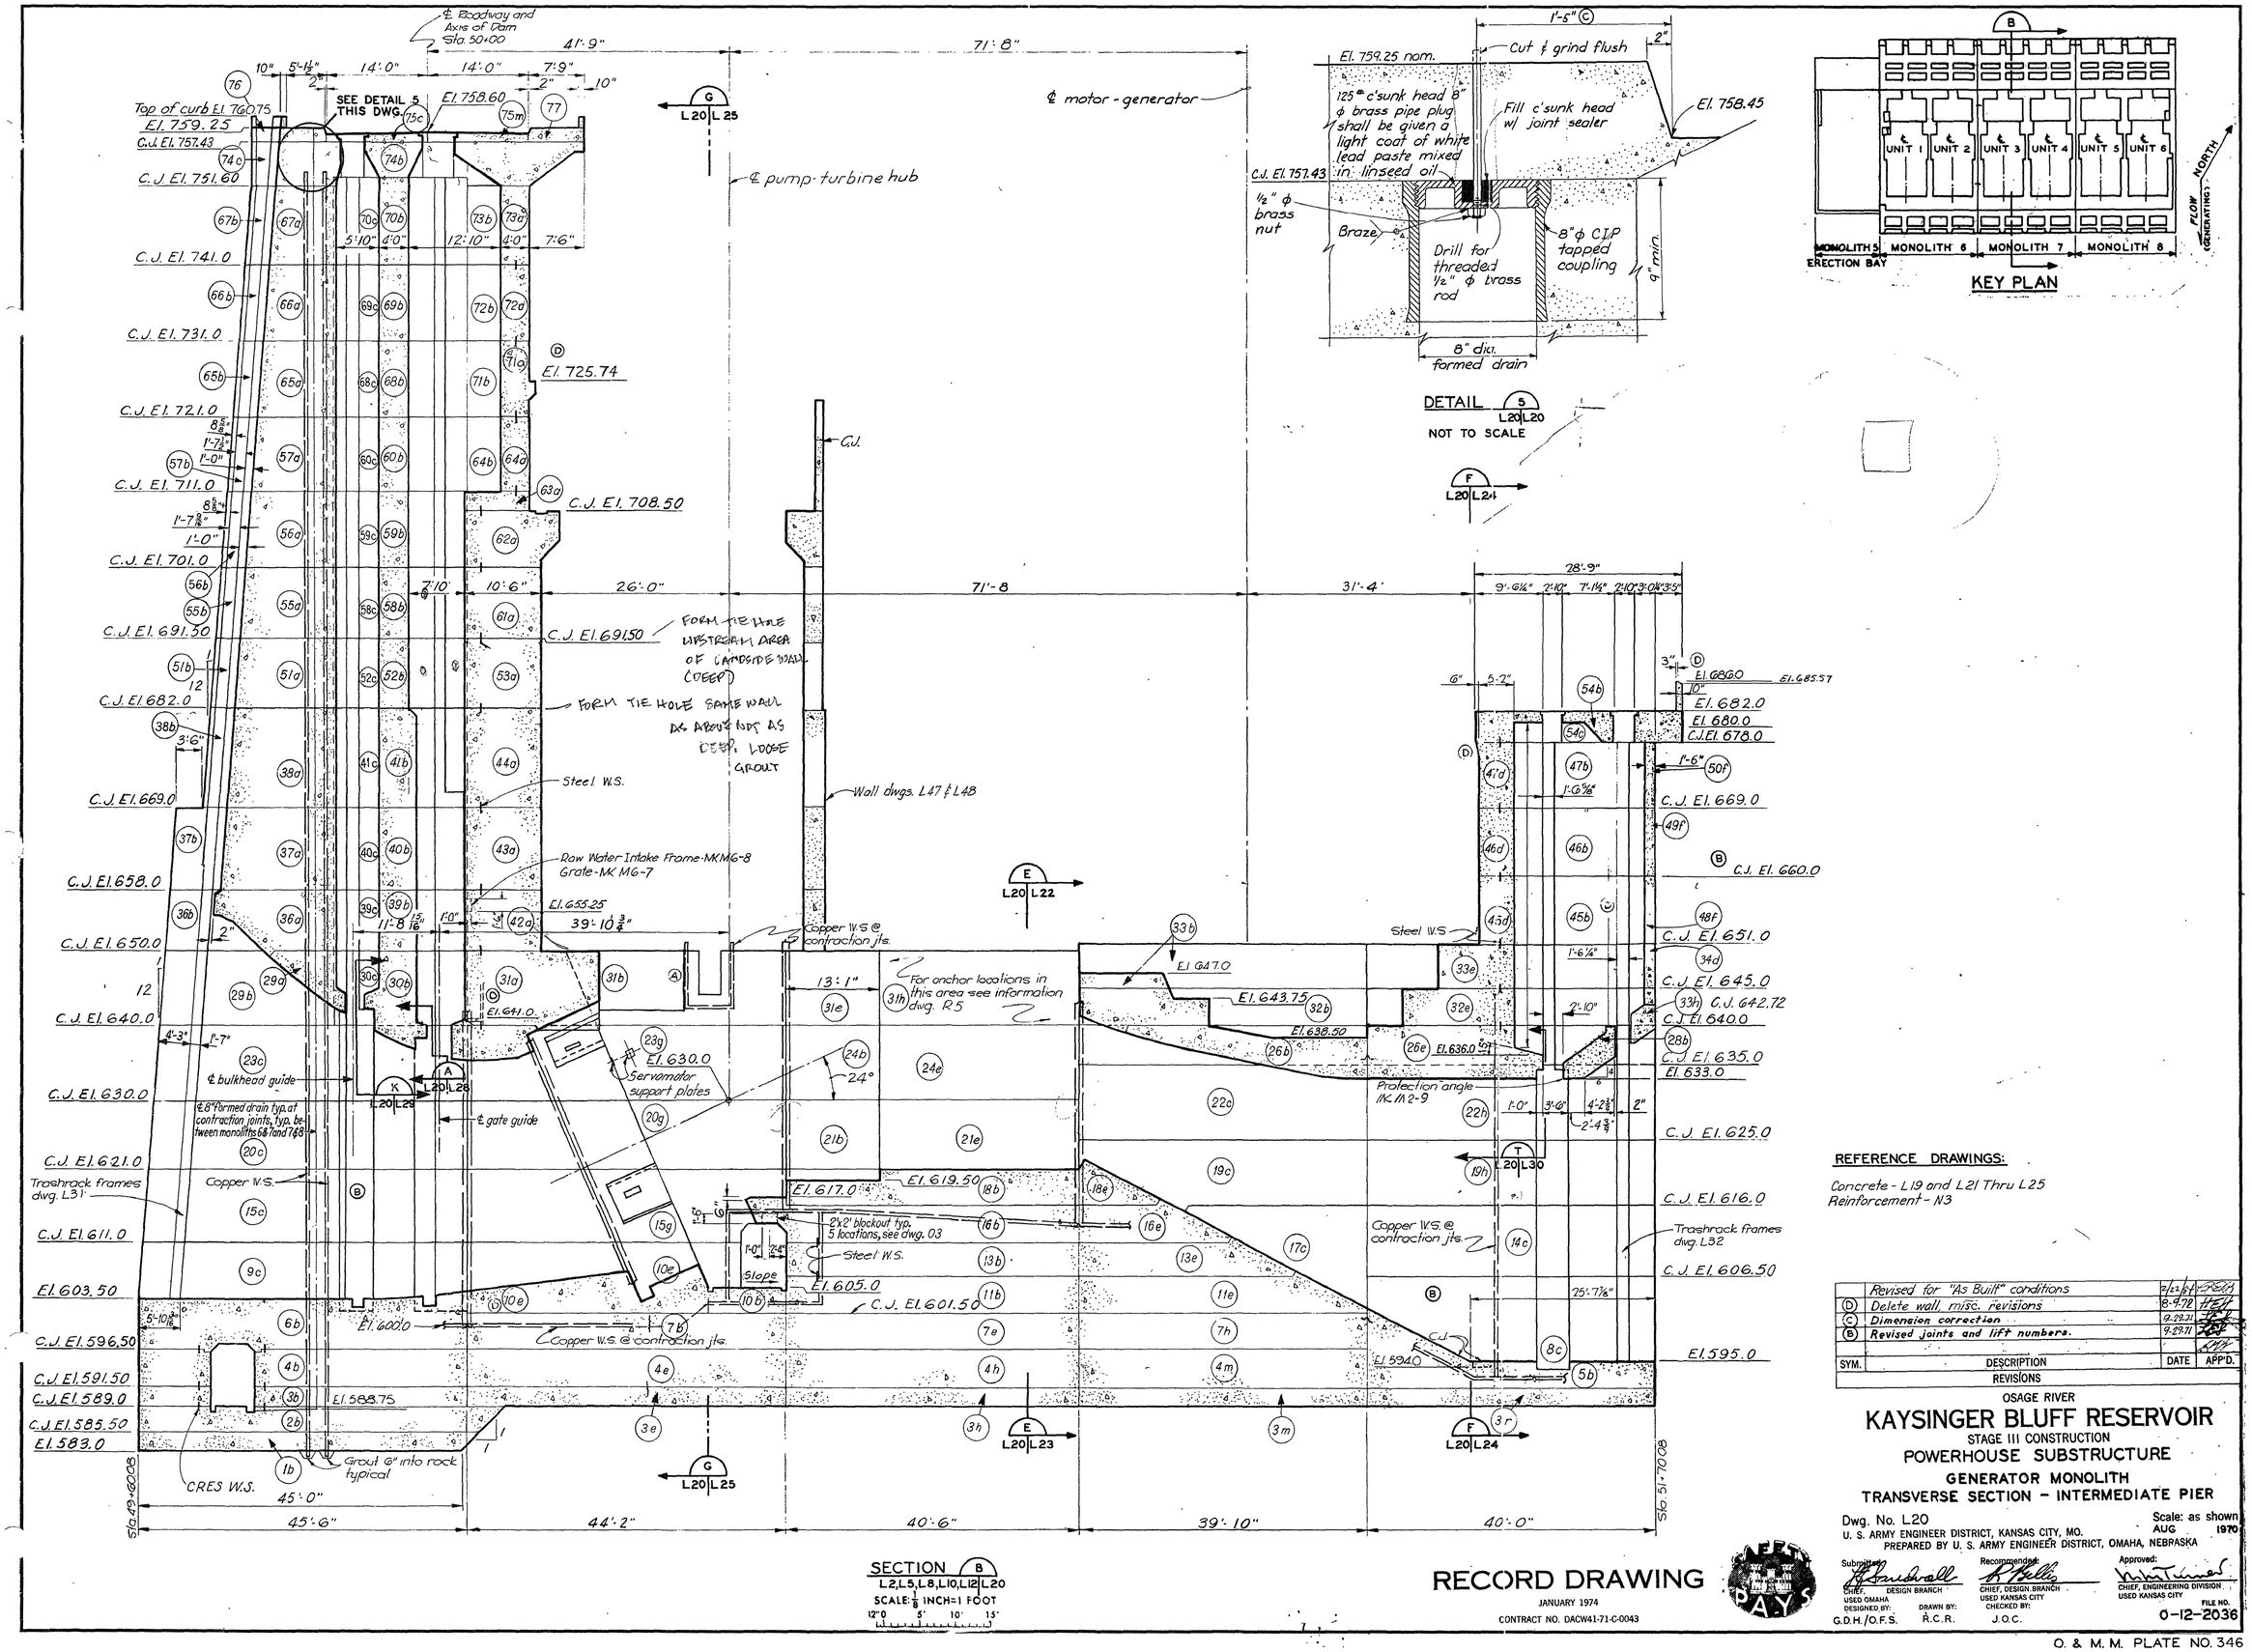

REFERENCE DRAWINGS:

Concrete - L19 and L21 Thru L25
Reinforcement - N3

SYM.	DESCRIPTION	DATE	APP'D.
	Revised for "As Built" conditions	2/13/74	
(D)	Delete wall, misc. revisions	8-9-72	
(C)	Dimension correction	9-29-71	
(B)	Revised joints and lift numbers.	9-27-71	

REVISIONS

OSAGE RIVER

KAYSINGER BLUFF RESERVOIR

STAGE III CONSTRUCTION

POWERHOUSE SUBSTRUCTURE

GENERATOR MONOLITH
TRANSVERSE SECTION - INTERMEDIATE PIER

Dwg. No. L20

Scale: as shown
AUG 1970

U. S. ARMY ENGINEER DISTRICT, KANSAS CITY, MO.
PREPARED BY U. S. ARMY ENGINEER DISTRICT, OMAHA, NEBRASKA

Submitted: CHIEF, DESIGN BRANCH USED OMAHA
DESIGNED BY: G.D.H./O.F.S. DRAWN BY: R.C.R.

Recommended: CHIEF, DESIGN BRANCH USED KANSAS CITY
CHECKED BY: J.O.C.

Approved: CHIEF, ENGINEERING DIVISION USED KANSAS CITY

FILE NO. 0-12-2036

RECORD DRAWING
JANUARY 1974
CONTRACT NO. DACW41-71-C-0043

O. & M. M. PLATE NO. 346