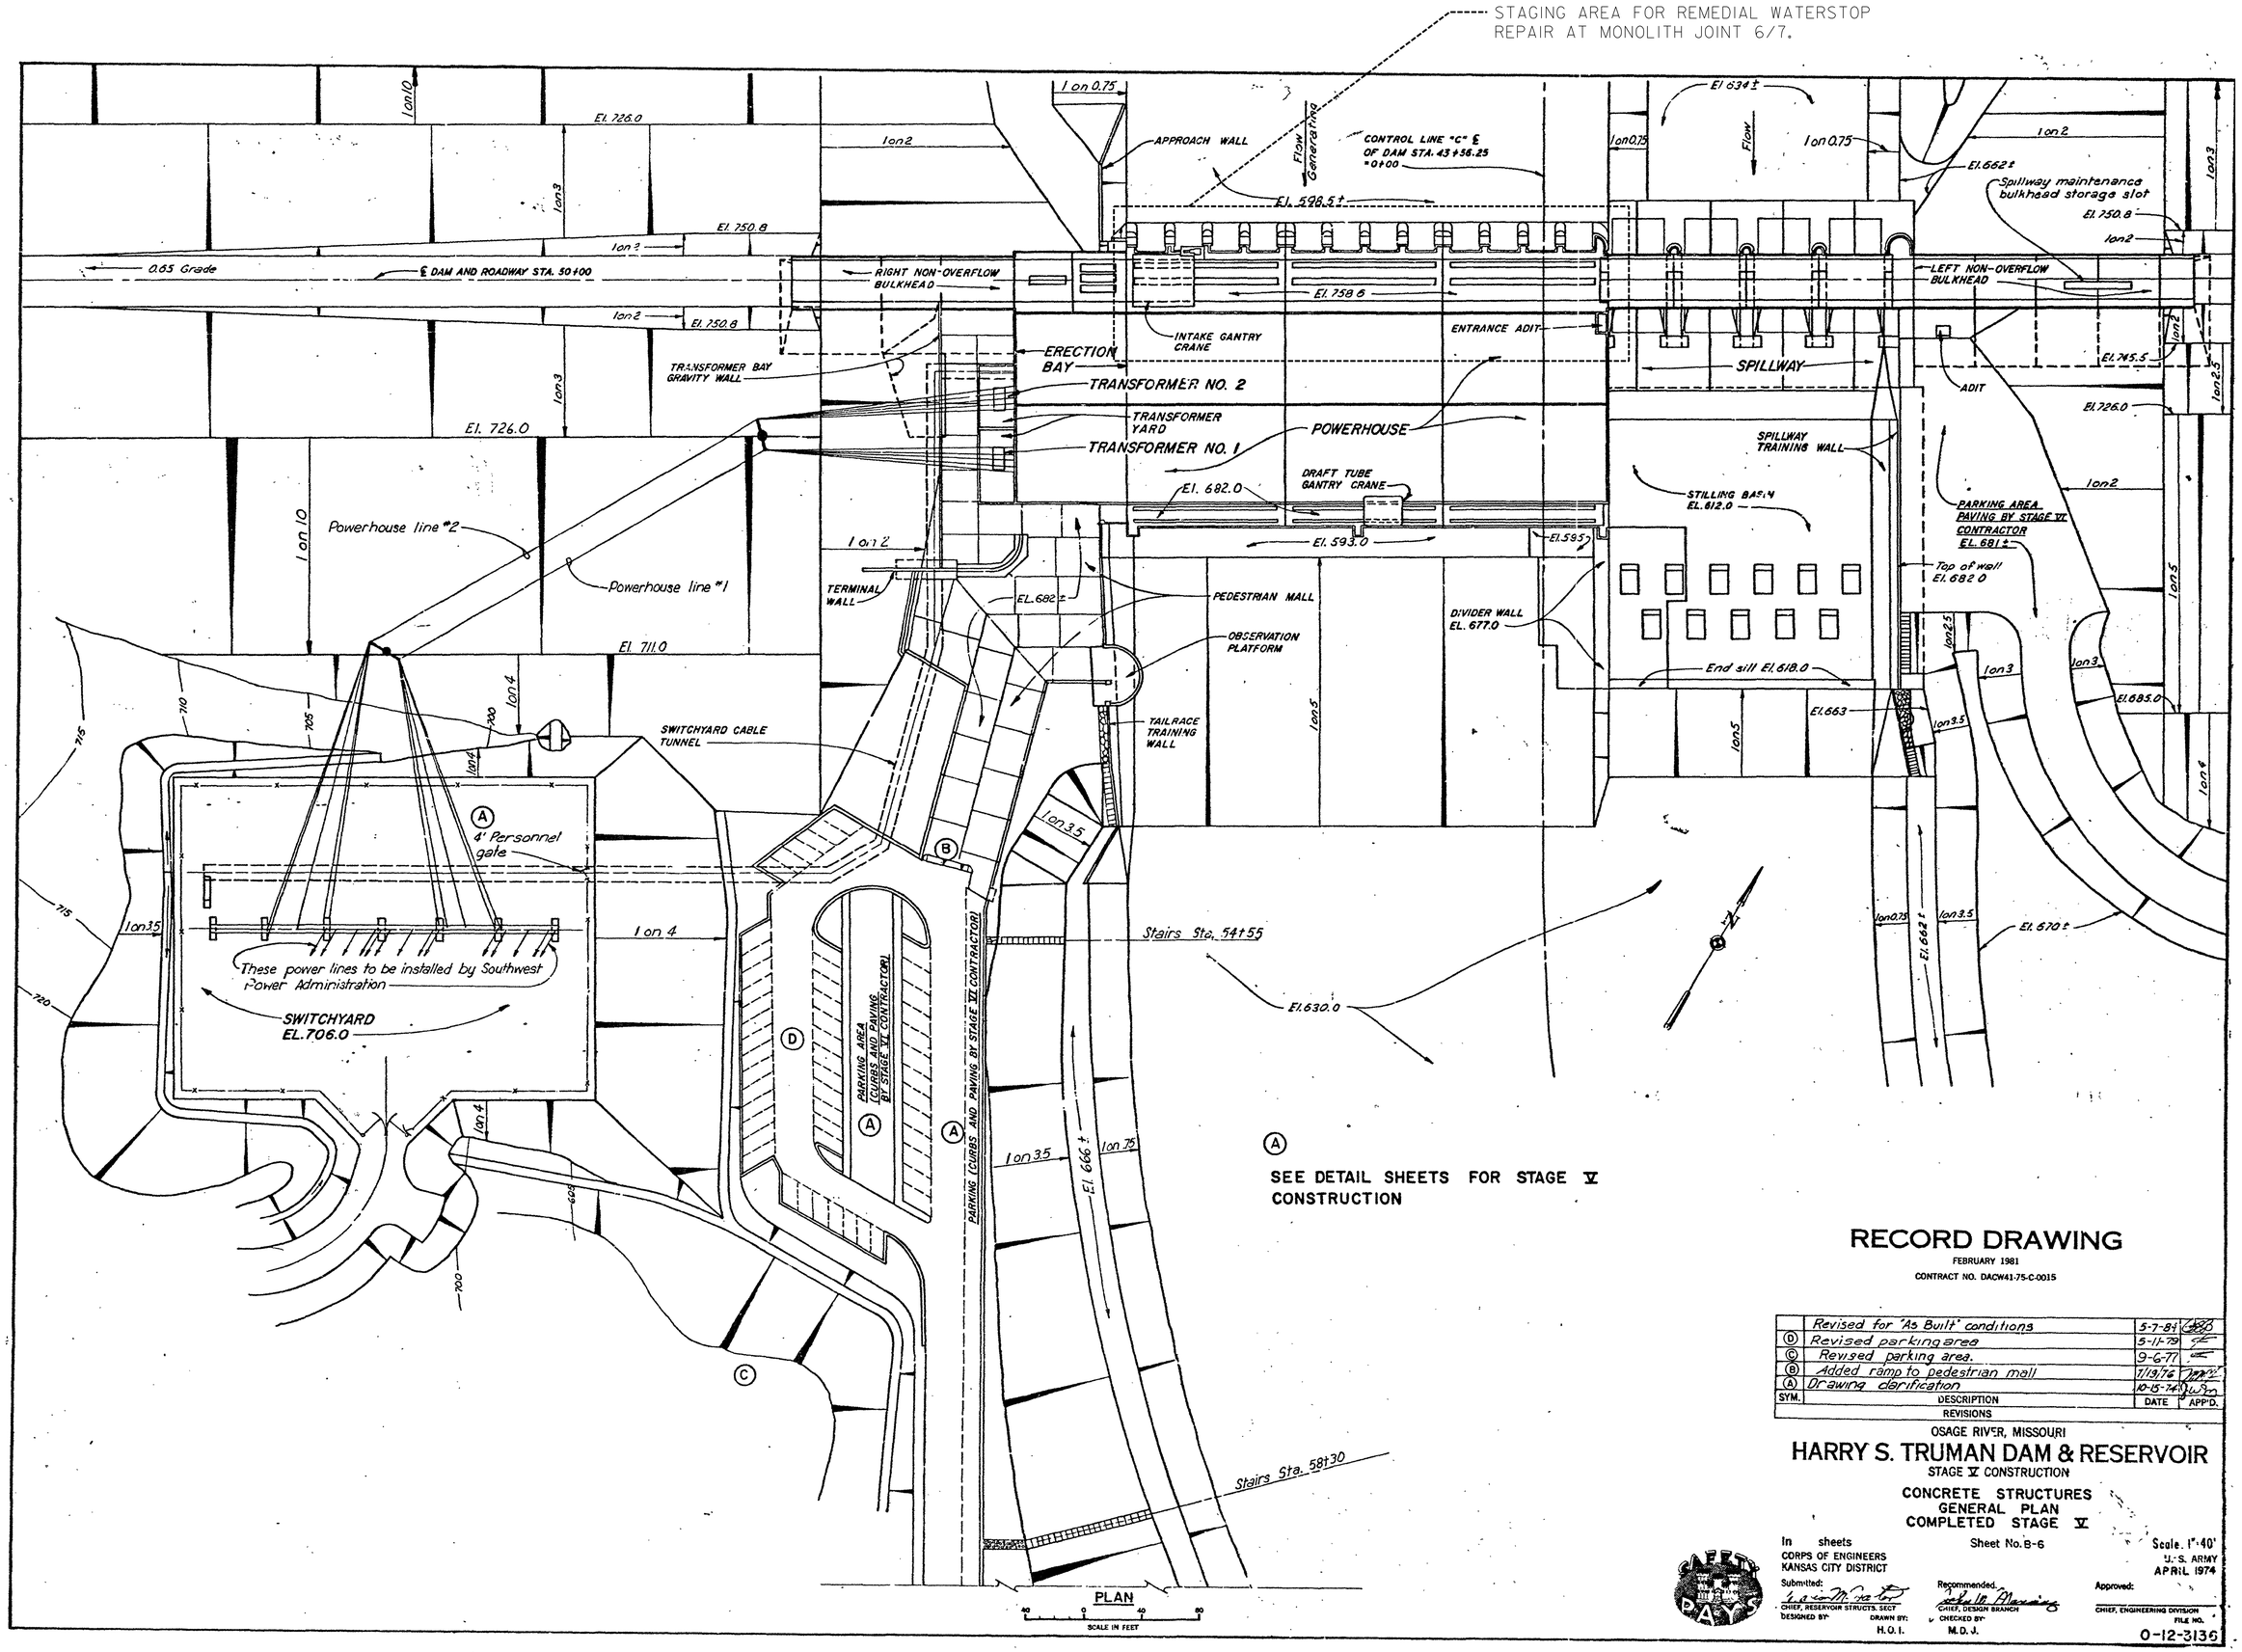

(A) SEE DETAIL SHEETS FOR STAGE V CONSTRUCTION

RECORD DRAWING

FEBRUARY 1981

CONTRACT NO. DACW41-75-C-0015

SYM.	DESCRIPTION	DATE	APP'D.
	Revised for 'As Built' conditions	5-7-84	
(D)	Revised parking area	5-11-79	
(C)	Revised parking area.	9-6-77	
(B)	Added ramp to pedestrian mall	7/19/76	
(A)	Drawing clarification	10-15-74	

REVISIONS

OSAGE RIVER, MISSOURI

HARRY S. TRUMAN DAM & RESERVOIR

STAGE V CONSTRUCTION

CONCRETE STRUCTURES
GENERAL PLAN
COMPLETED STAGE V

In sheets
CORPS OF ENGINEERS
KANSAS CITY DISTRICT

Sheet No. B-6

Scale. 1"=40'
U. S. ARMY
APRIL 1974

Submitted: CHIEF, RESERVOIR STRUCTS. SECT
DESIGNED BY: DRAWN BY: H.O.I.

Recommended: CHIEF, DESIGN BRANCH
CHECKED BY: M.D.J.

Approved: CHIEF, ENGINEERING DIVISION
FILE NO. 0-12-3136

O & M. M. PLATE NO. 506