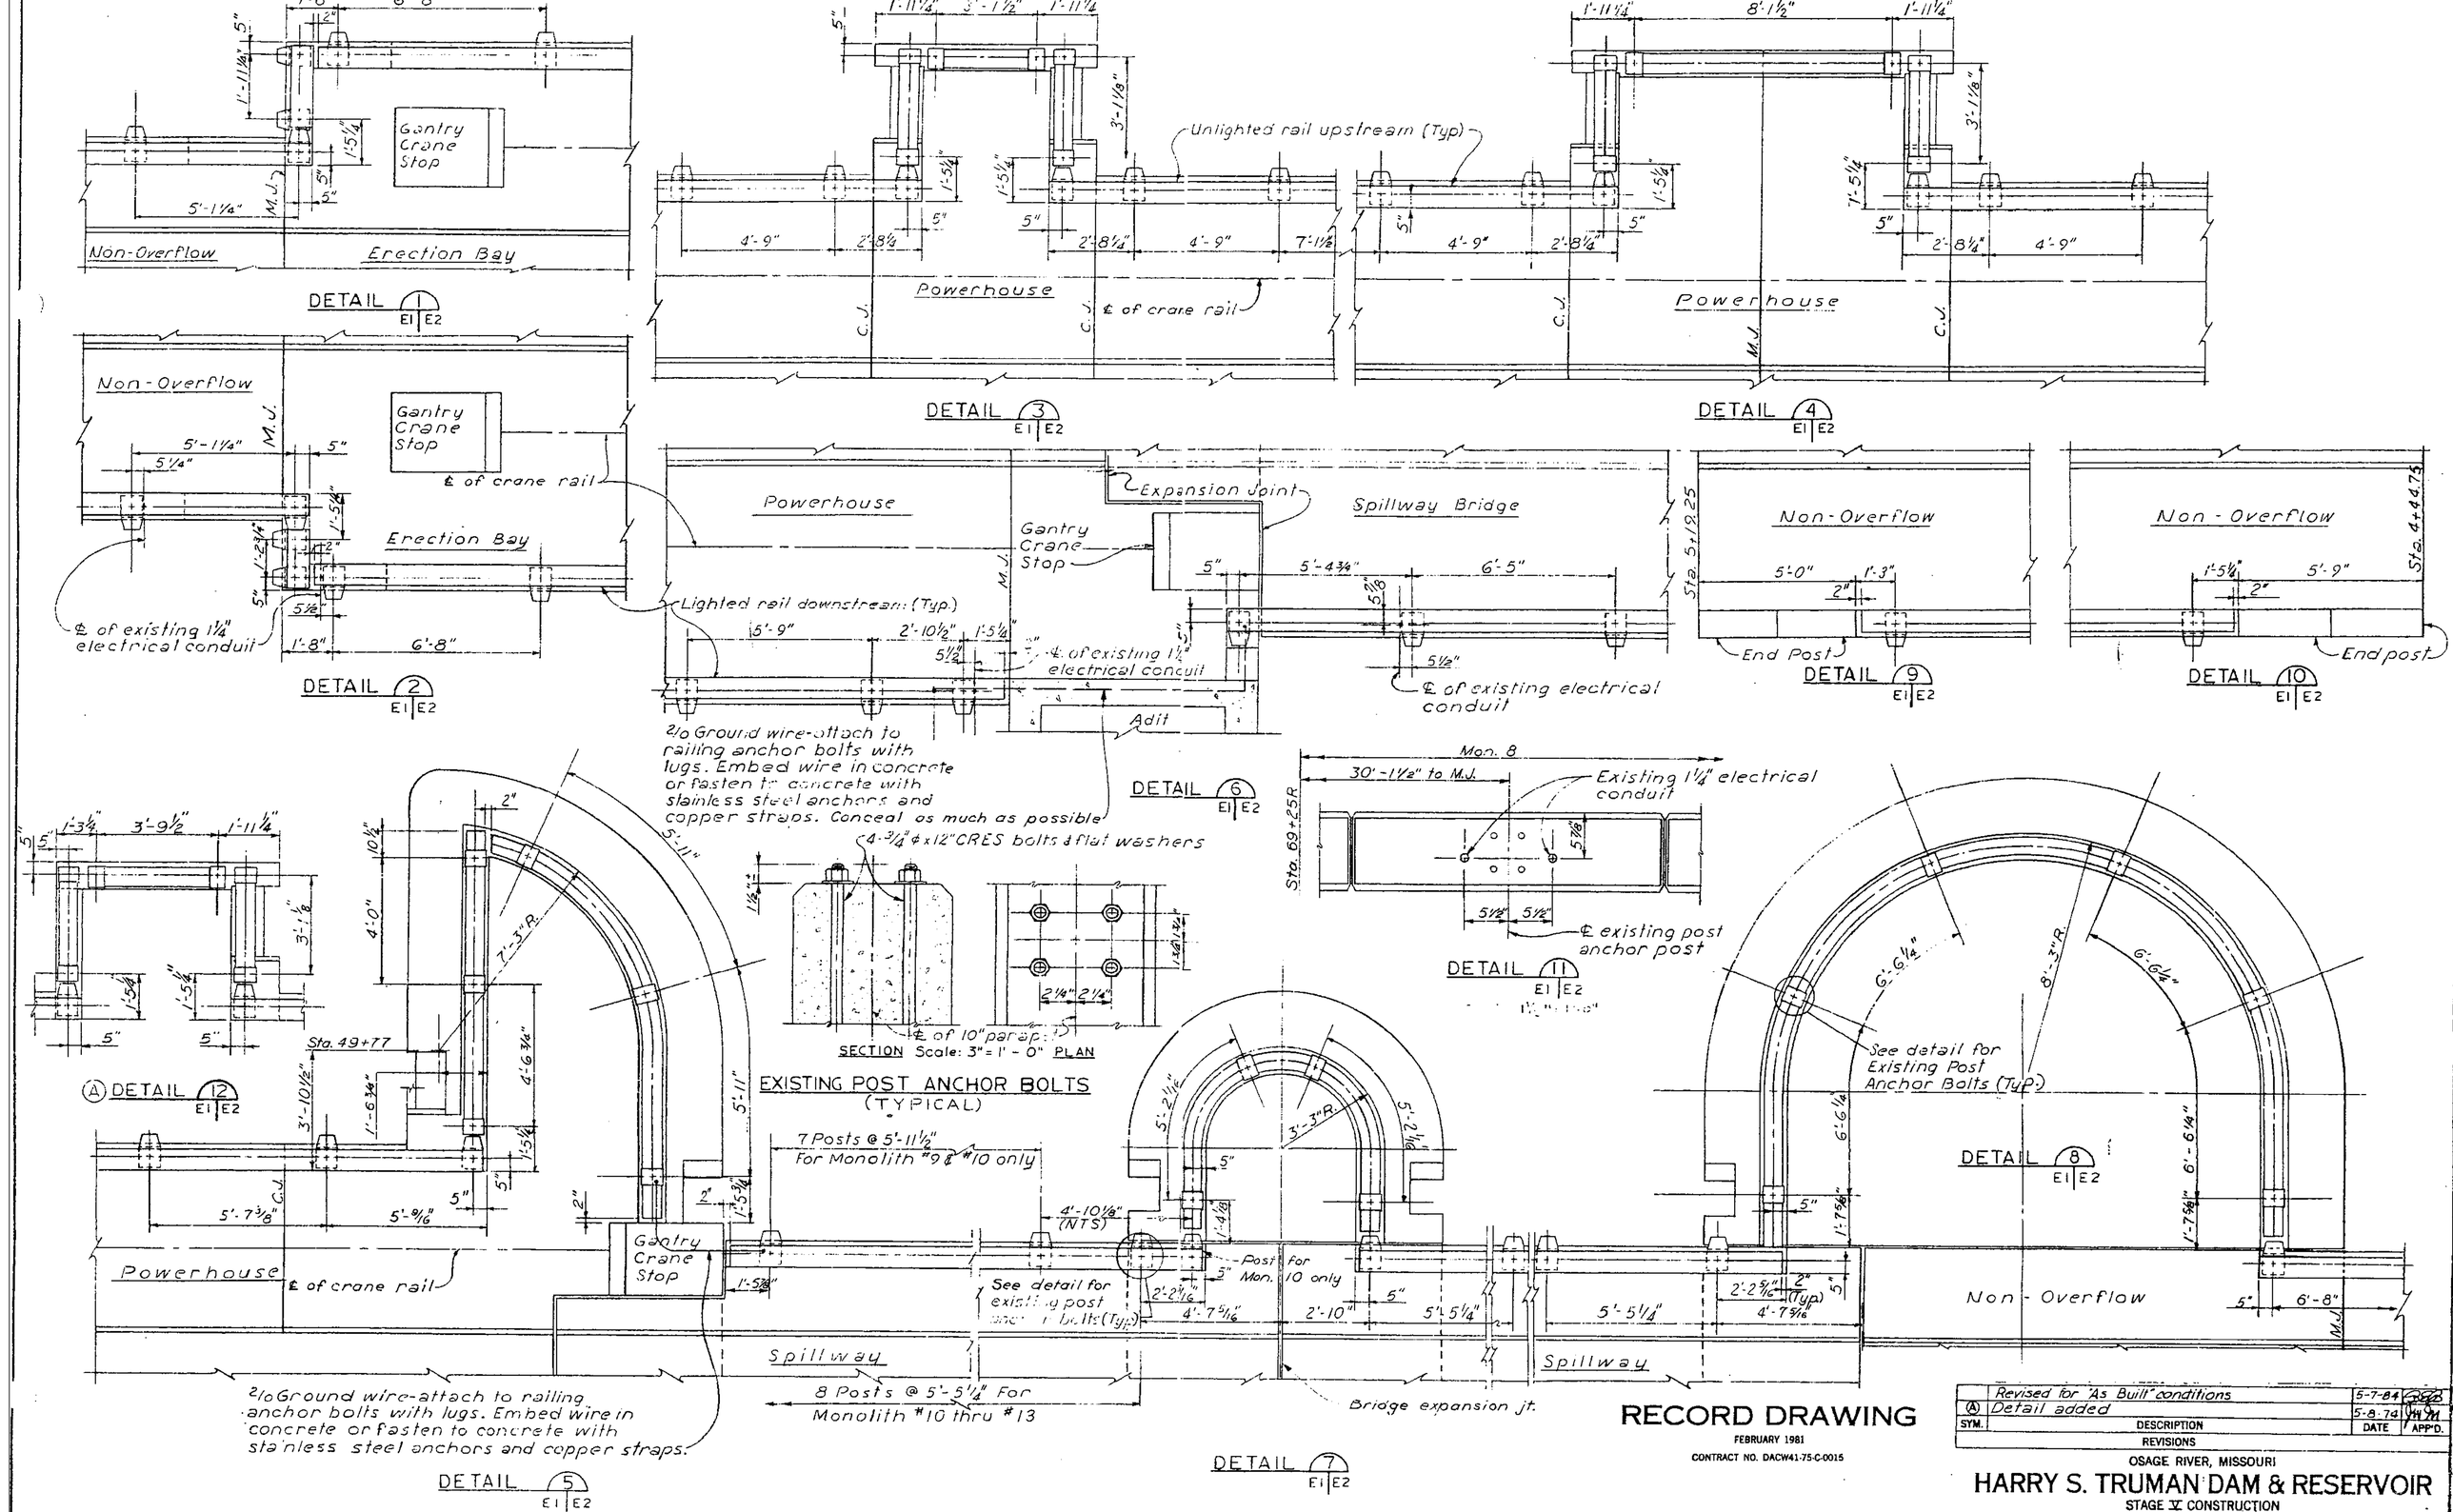

NOTES:
See Dwg. E5 for Typical corner detail.
Top rail not shown.

Scale: ½" = 1' - 0"
(Except as noted)

RECORD DRAWING
FEBRUARY 1981
CONTRACT NO. DACW41-75-C-0015

SYM.	DESCRIPTION	DATE	APP'D.
	Revised for "As Built" conditions	5-7-84	
(A)	Detail added	5-8-74	

REVISIONS

OSAGE RIVER, MISSOURI

HARRY S. TRUMAN DAM & RESERVOIR

STAGE V CONSTRUCTION

ROADWAY AND BRIDGE RAILING AND POST PLANS AND DETAILS

In sheets — Sheet No. E-2 — Scale: as shown

CORPS OF ENGINEERS
KANSAS CITY DISTRICT

U. S. ARMY
APRIL 1974

Submitted: CHIEF, RESERVOIR STRUCTS. SECT.
Recommended: CHIEF, DESIGN BRANCH
Approved: CHIEF, ENGINEERING DIVISION

DESIGNED BY: M. D. J. DRAWN BY: H. O. I. CHECKED BY: M. D. J.

FILE NO. 0-12-3174

O. & M. M. PLATE NO. 544

HRT00544.dgn 04/23/2004 10:49:36 AM